

Name Lexington Const. Co.

Service No. 28

Address 7 Henderson Road

Lexington, Mass.

Location 7 Henderson Road

Kind of Pipe

Size

Size of Main

Repair - Renewal - New Service

*Com. 5/2/50*

Location

Date	Material	Amount	Total	Date	Location	Amount
Mar. 27, '50	Labor	15 40	15 40	<i>Mar 13 '50</i>	<i>Deposited</i>	40 00
	10% Overhead		1 54	<i>May 25 '50</i>	<i>Deposited</i>	1 52
	43' - 3/4" Copper Tubing @.23		9 89		No Charge	33 87
	1 - 3/4" C x 1/2" I.W.H. S&W		3 29	Mar. 27, '50	Labor	14 00
	Town Shovel 1 hr. @ 3.00		3 00		12' - 3/4" Copper Tubing @.23	2 76
	Trucking 1 hr. @.75		75		1 - 3/4" C Corp-cock	3 15
			33 87		1 - 3/4" C x 3/4" C Curb-cock	3 85
					1 - Box & Rod	3 70
					1 - 1/2" Straight Tail Piece	38
					1 - 1/2" Offset Tail Piece	38
					Town Shovel 1 1/2 hrs. @ 3.00	4 50
					Trucking 1 hr. @.75	75
	Labor					33 47

DATE \_\_\_\_\_

TOWN OF LEXINGTON - BOARD OF PUBLIC WORKS

**WATER DIVISION**

The undersigned applies for a supply of water at No..... St. and hereby agrees to comply with the rules and regulations as now, or at any future time, established by the Board of Selectmen.

Am't of Estimate \$.....

Owner .....


Am't Paid \$.....

Address .....

Builder .....

.....

Sketch of Service Here

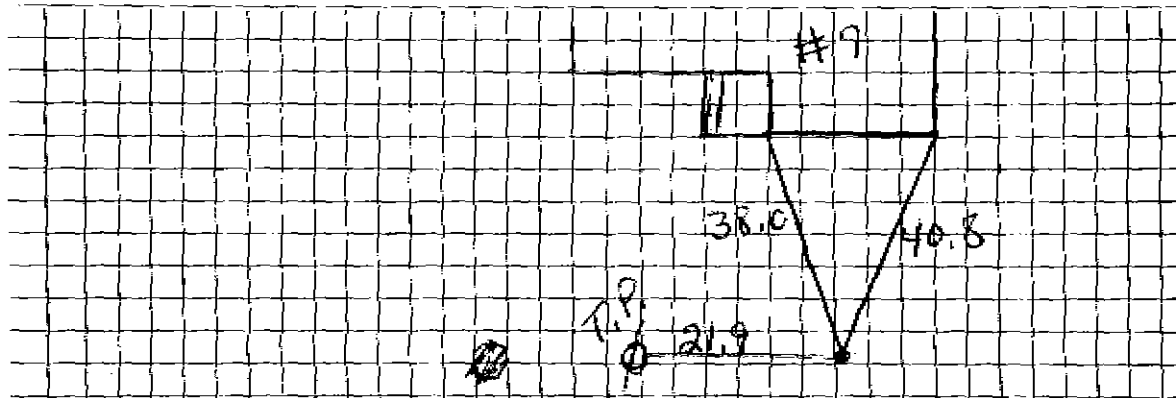

Connection made in ..... Street.

Work completed .....19

Remarks: