

WATER SERVICE RECORD

#2963

Name John Dennison

Service No. 334

Address 8 Henderson Road

Location

Repts. - ~~Receipt~~ - New Service

Comm. 4/1/57


Date		Material	Amount	Total	Date		Amount
11/3/56		Labor	1 90		11-2-56	Deposit	\$ 50 00
		10% overhead	20	2 10	4-1-56	Refund \$	9 15
		70' - 3/4" Copper tubing @ .4396	30 77			NON CHARGE	\$ 40 85
		1 - 3/4" Cx 1/2 I. W.H. Stop & Waste	4 96		1 - 1/2	Straight tailpiece	50
		1 - 3/4" Union (3 part)	2 27		1 - 1/2	Offset tailpiece	50
		1 hr. trucking		75			1 00
				40 85			
					1956 28'	INST By Cont.	
						3/4 COPPER	
						3/4 CORP	
						3/4 CURB	
						\$ Applied \$ 9.15 to S.H.C. #164	
						Box + Rod	

DATE _____

TOWN OF LEXINGTON — BOARD OF PUBLIC WORKS

WATER DIVISION

Sketch of Service Here

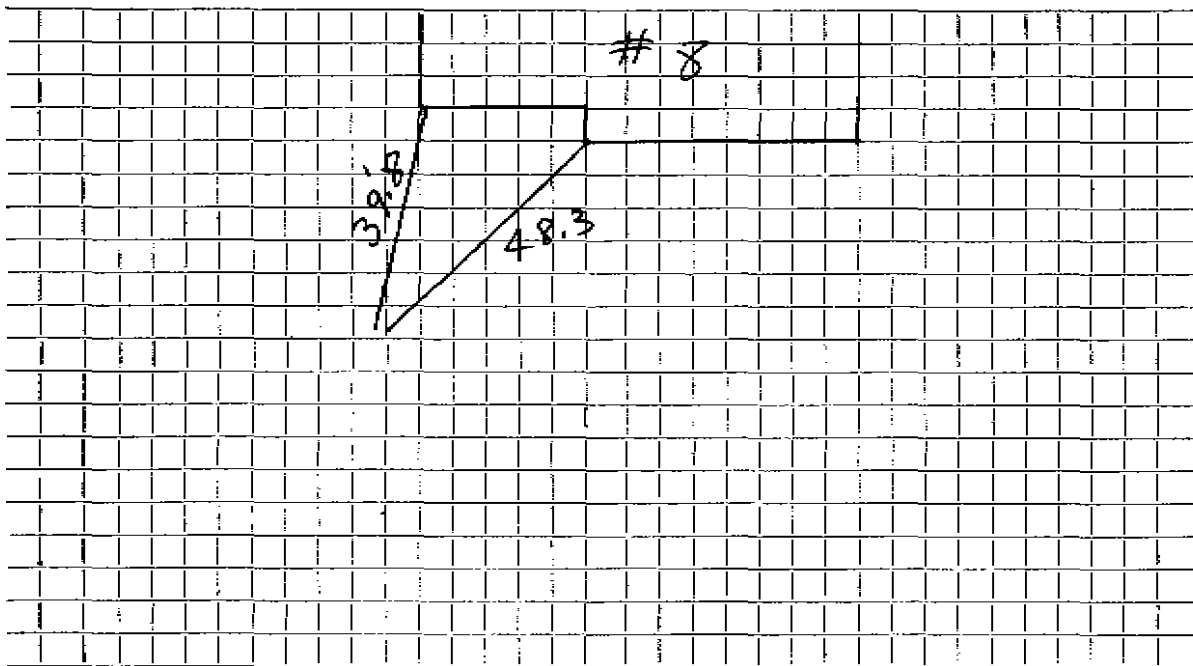

Connection made in _____ Street. Work completed _____

Remarks: IN DRIVEWAY

.....
.....