




WATER DIVISION

Sketch of Service Here

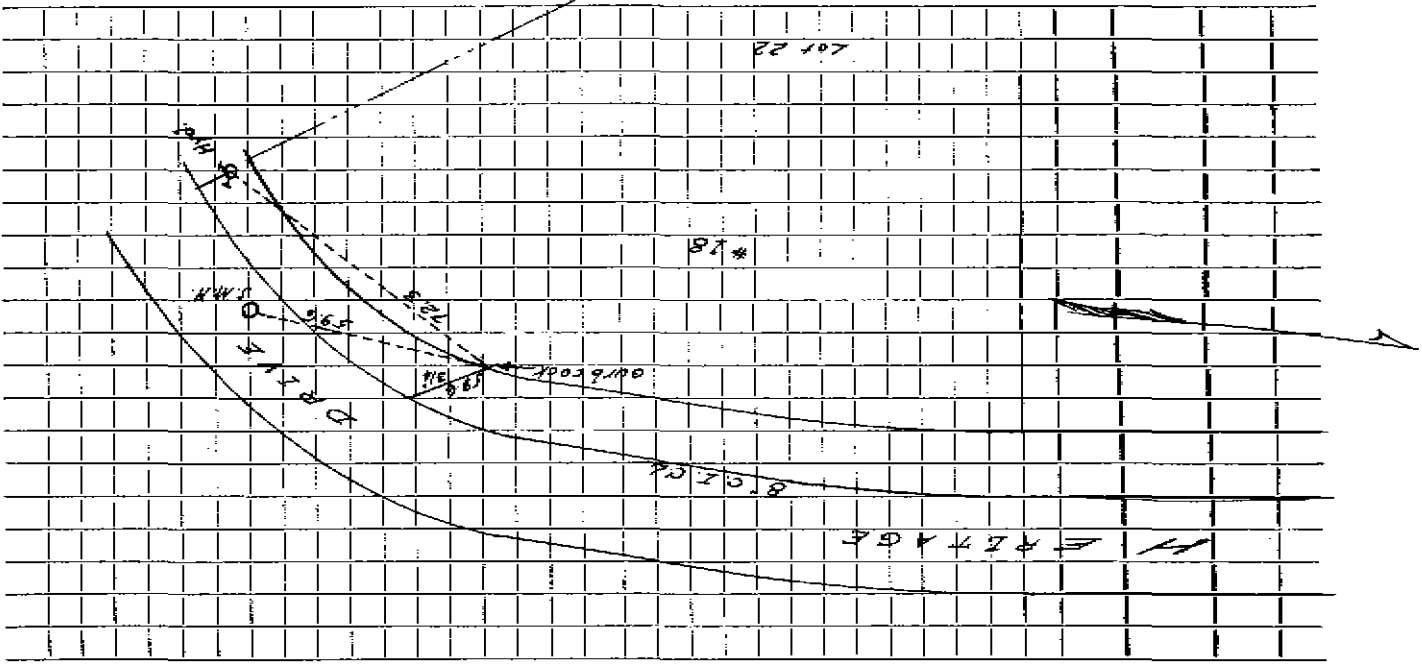

Work completed

Street.

Connection made in

Remarks: