




TOWN OF LEXINGTON — BOARD OF PUBLIC WORKS

WATER DIVISION

DATE \_\_\_\_\_

Sketch of Service Here

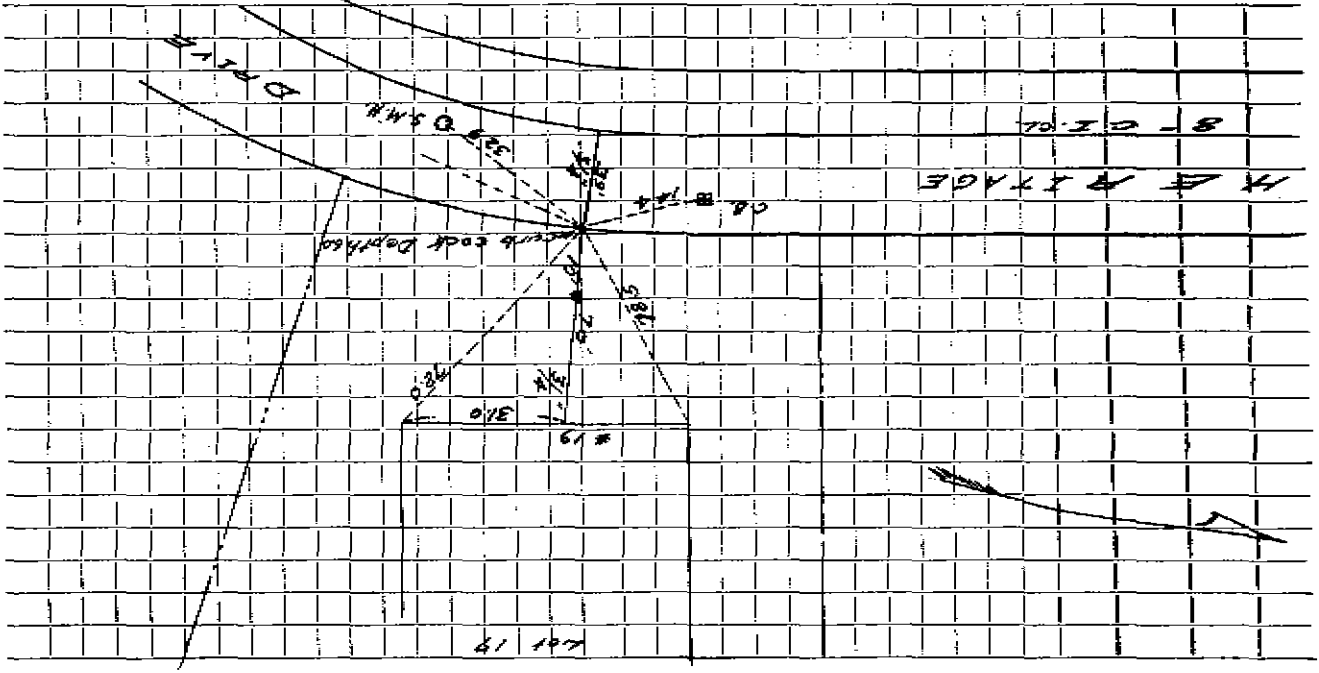

Connection made in \_\_\_\_\_

Street \_\_\_\_\_

Work completed \_\_\_\_\_

Remarks: \_\_\_\_\_