




DATE \_\_\_\_\_

TOWN OF LEXINGTON - BOARD OF PUBLIC WORKS  
WATER DIVISION

Sketch of Service Here

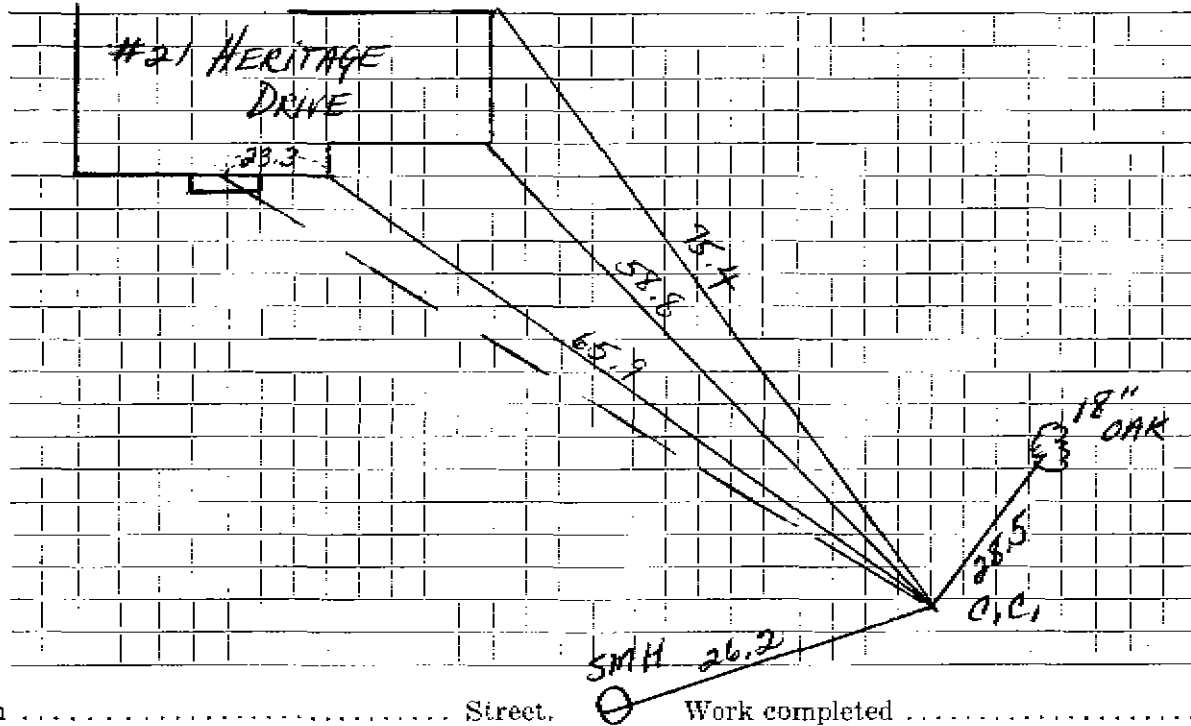

Connection made in ..... Street.  Work completed .....

Remarks: .....

.....

.....