

WATER SERVICE RECORD

Name Castano Nicolai Jr.

Service No. 52

Address 24 Heritage Drive

Location Lot #7

Repair—Renewal—New Service W.O. #5281 Sibley #752


MAR 18, '68

Date	Material	Amount	Total	Date	Amount
8-24-67	83' 3/4" Copper tubing			8-10-67	Deposit 125.00
8-10-67	Labor 46.12			4-16-68	Paid 44.13
8-11-68	" 26.04	72.16			169.13
	10% O.H.	7.22	79.38		
	28' 3/4" Copper tubing @.79		22.12		
	1 3/4" Corp Cock		7.42		
	1 3/4" Curb cock		8.76		
	1 Box & Rod		5.10		
	1/4 ton Cold Patch		1.25		
	2 ton Hot Top		11.60		
	2 1/2 hrs. Trucking @3.00		7.50		
	3 hrs. Town Shovel @6.50		19.50		
	1 hr. Compressor		5.00		
	1/2 hr. Roller @3.00		1.50		
			169.13		

DATE _____

TOWN OF LEXINGTON — BOARD OF PUBLIC WORKS
WATER DIVISION

Sketch of Service Here

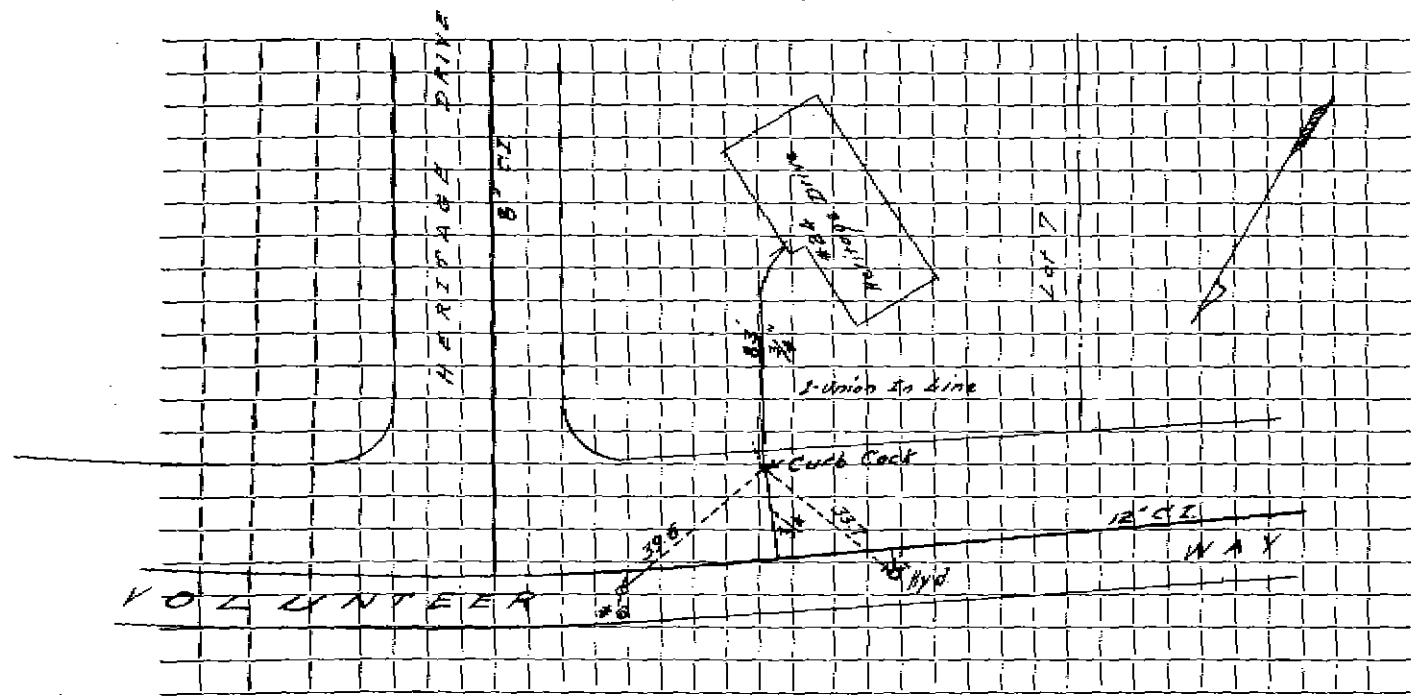

Connection made in _____ Street. Work completed _____

Remarks: _____

