




DATE 7/16/18

TOWN OF LEXINGTON — BOARD OF PUBLIC WORKS  
WATER DIVISION

Sketch of Service Here

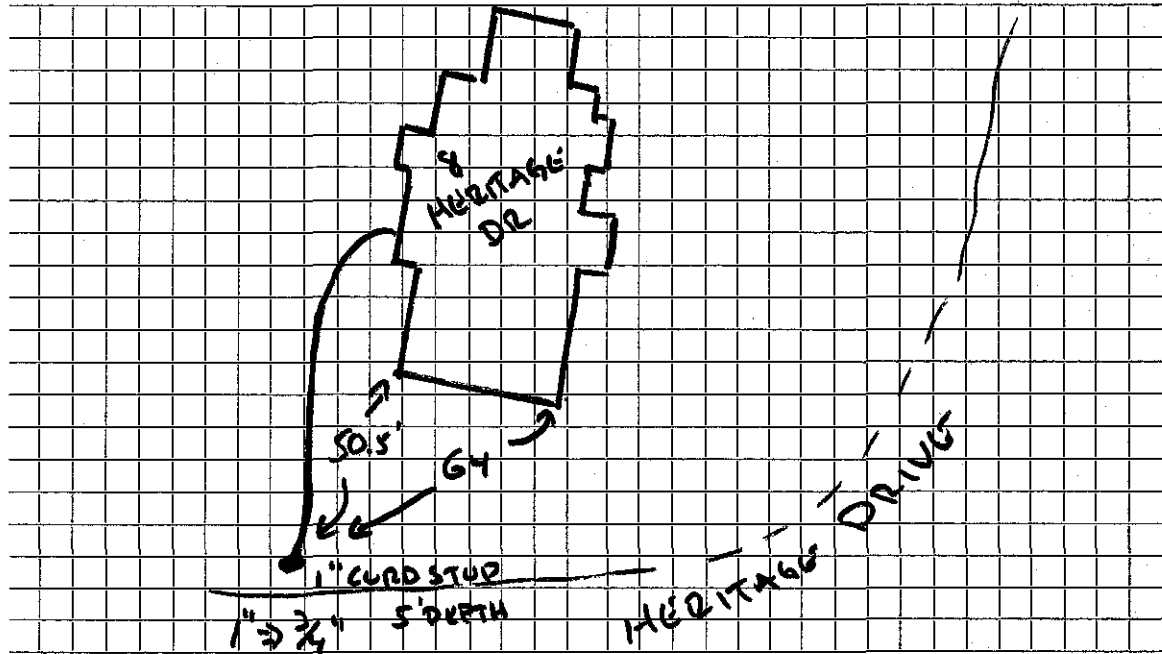

Connection made in HERITAGE Street. Work completed PECORA CONTRACTING

Remarks: .....

.....

.....