


DATE _____

TOWN OF LEXINGTON — BOARD OF PUBLIC WORKS

WATER DIVISION

Sketch of Service Here

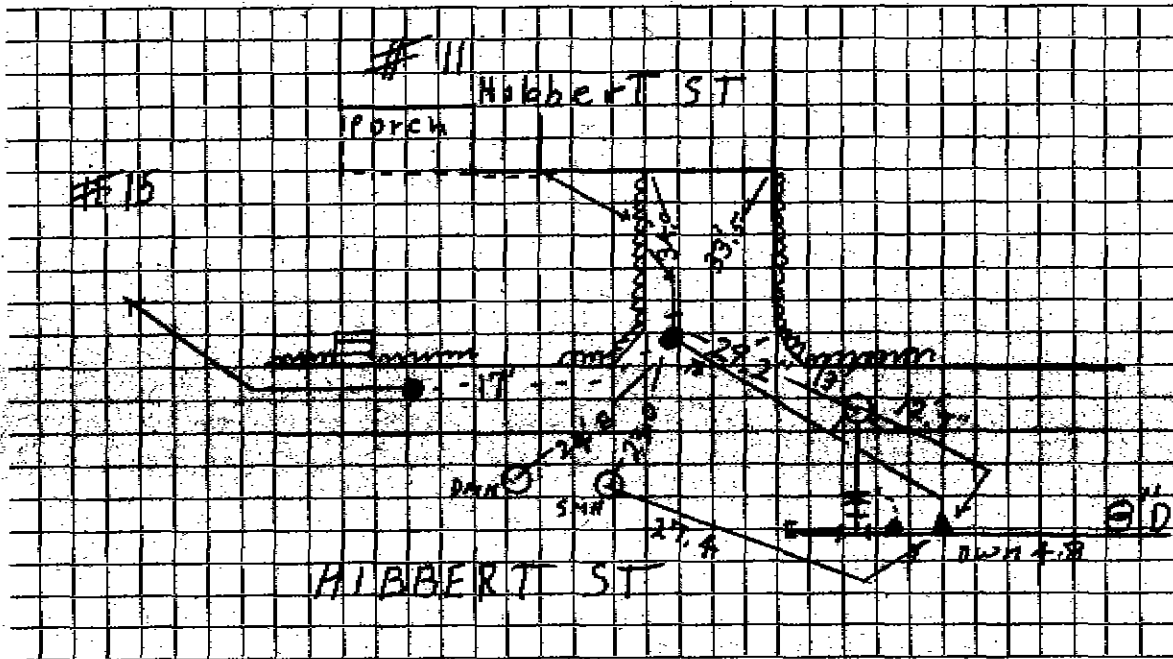

Connection made in _____ Street. Work completed 9/1/09

Remarks: CURB DOWN 4' 1"
CONP'S. FOR #11-15 Tapped 1' apart