

## WATER SERVICE RECORD

Name Morris Berman

Service No. 4

Address ~~6 Hibbert Street~~

Location #3 Hibbert St. - Changed per Eng. Dept. 9/18/68

~~Repair, Renewal~~ New Service

Cmn 6-1-59


Date	Material	Amount	Total	Date	Amount
4-17-59	Labor	7.40		3-9-59	Deposit 25.00
	10% O.H.	.74	8.14	6-1-59	* Refund 2.57
21'	3/4" Copper tubing @.3666		7.70		22.43
1	3/4" C x 1/2 I.W.H. Stop & Waste		5.84		NON CHARGE
1	hr. Trucking @.75		.75		Labor 81.46
			22.43	15'	3/4" Copper tubing @.3666 5.50
				1	3/4" C 3 part union 2.27
				1	3/4" C Curb Cock 6.03
				2	1 1/2" Style 38 Repair Cl. @2.50 5.00
				2	1 1/2"x6"C.L.Nipple @.34 .68
				1	Box & Rod 5.00
				4	hrs. Town Shovel @6.50 26.00
				2	hrs. Trucking @.75 1.50
				1	hr. Hough Loader @3.00 3.00
					136.44
					* Applied to SPC# 2

DATE \_\_\_\_\_

**TOWN OF LEXINGTON — BOARD OF PUBLIC WORKS**

**WATER DIVISION**

Sketch of Service Here

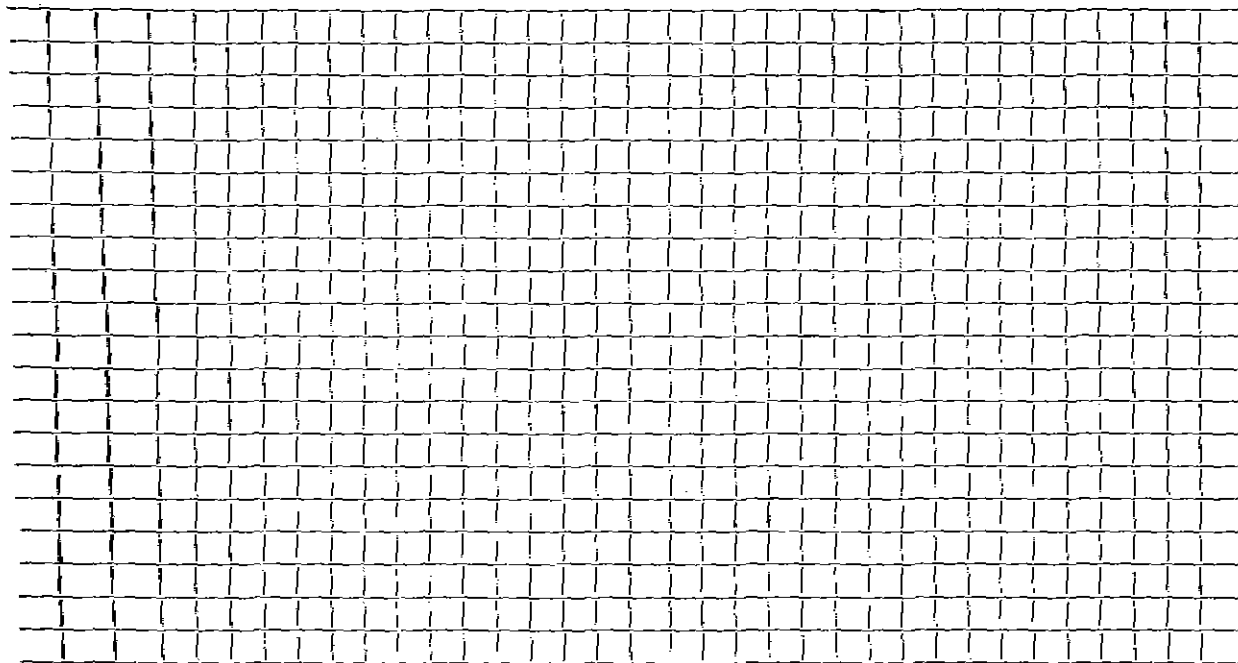

Connection made in ..... Street. Work completed .....

Remarks: .....  
.....  
.....