




TOWN OF LEXINGTON — BOARD OF PUBLIC WORKS

WATER DIVISION

Sketch of Service Here

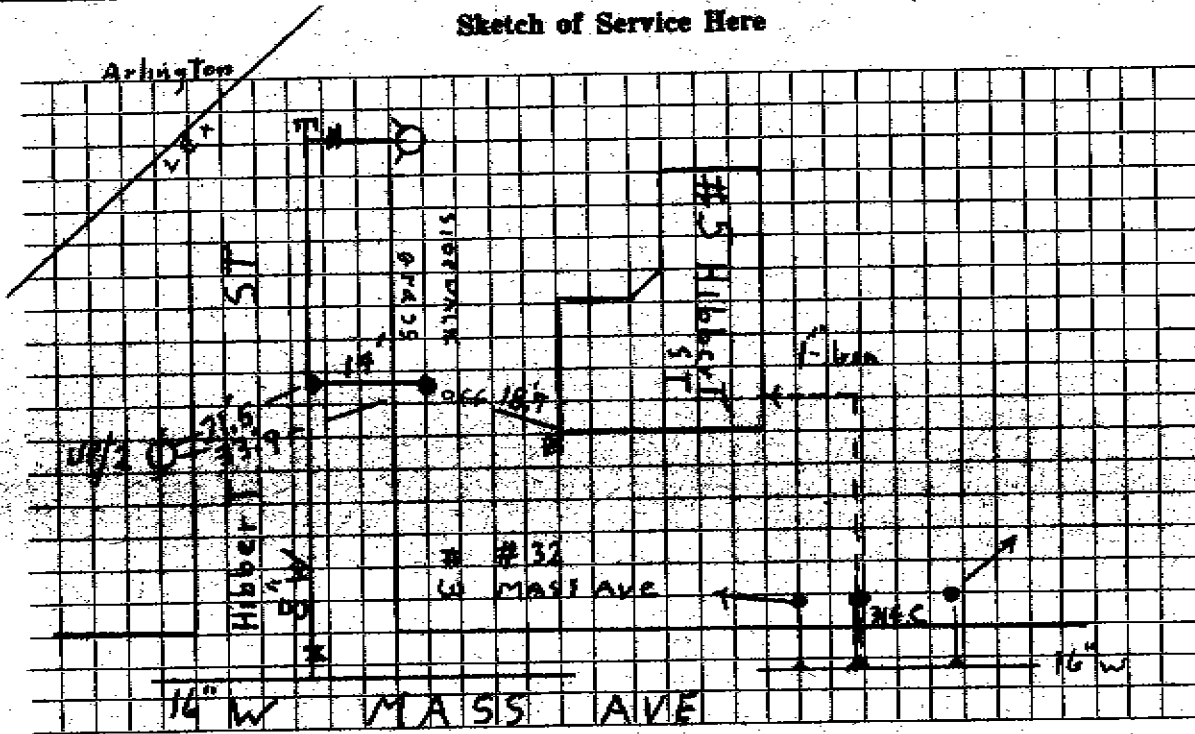

Connection made in Hibbert ST Street. Work completed .....

Remarks: 1" service to replace iron service from Mass Ave (if needed) in off position.....