




DATE

TOWN OF LEXINGTON — BOARD OF PUBLIC WORKS

WATER DIVISION

Sketch of Service Here

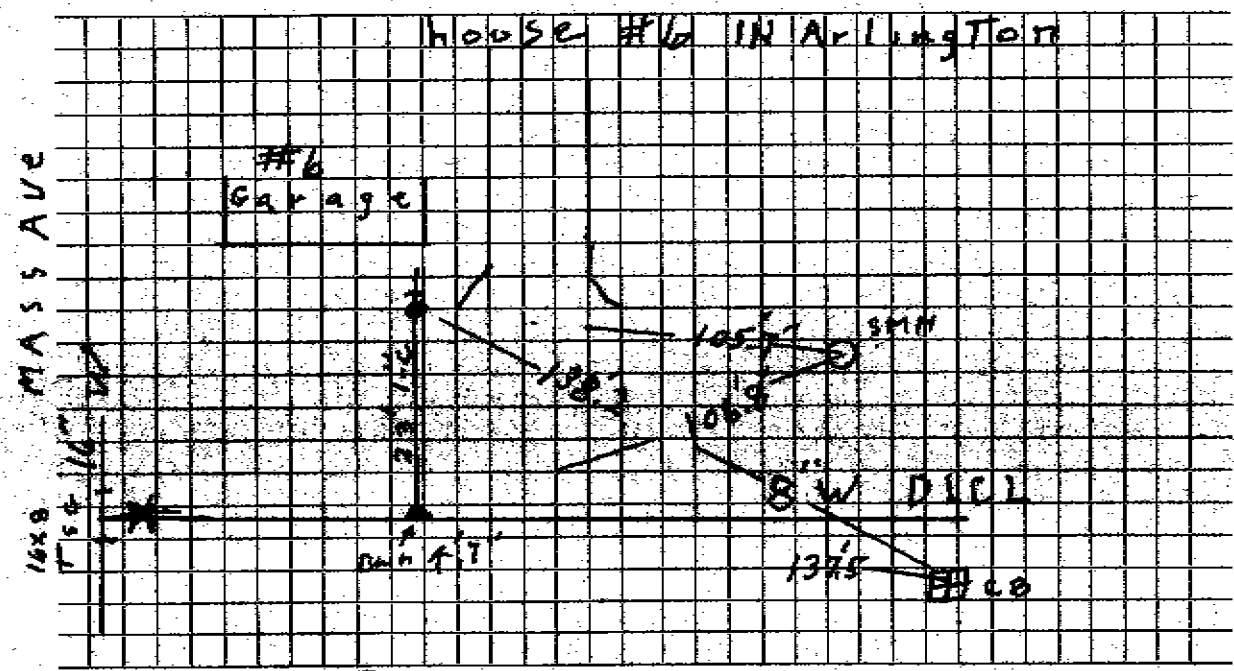

Connection made in Hibbert St Street. Work completed 7/2/09 P.A.O

Remarks: service for garage, house service from Arlington