




DATE \_\_\_\_\_

TOWN OF LEXINGTON — BOARD OF PUBLIC WORKS

**WATER DIVISION**

Sketch of Service Here

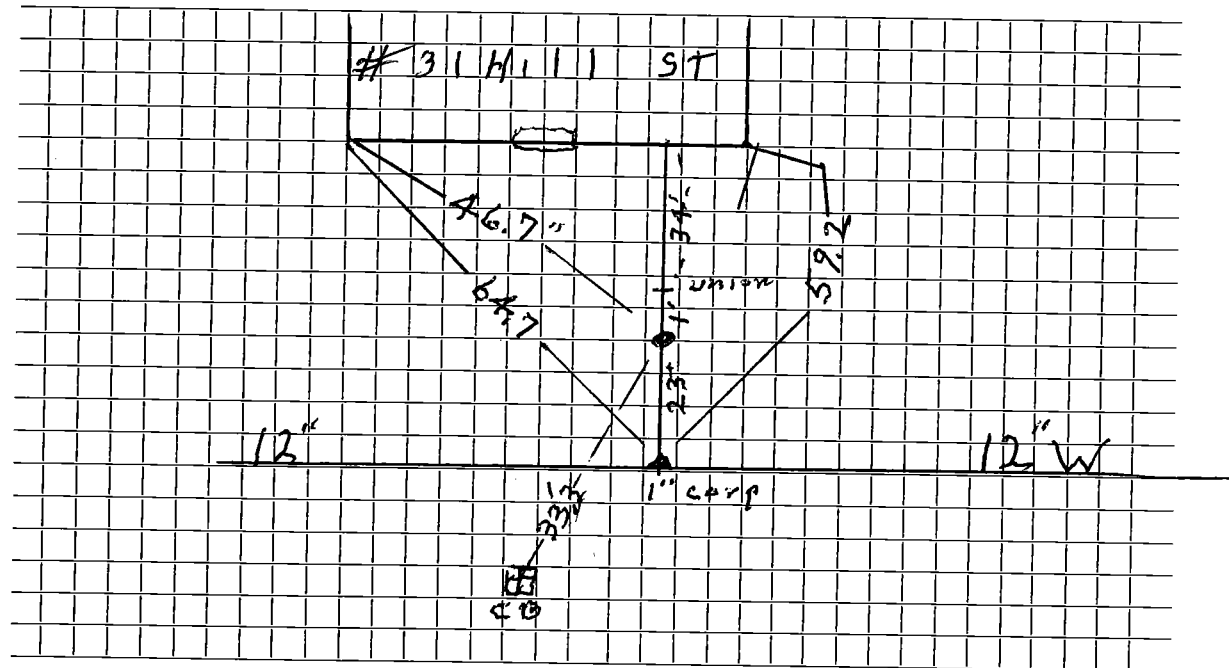

Connection made in..... Street. Work completed 11-5-12 Cedron

Remarks: Ledge around 12" water main

.....  
.....