




DATE MARCH 2019

TOWN OF LEXINGTON — BOARD OF PUBLIC WORKS

WATER DIVISION

Sketch of Service Here

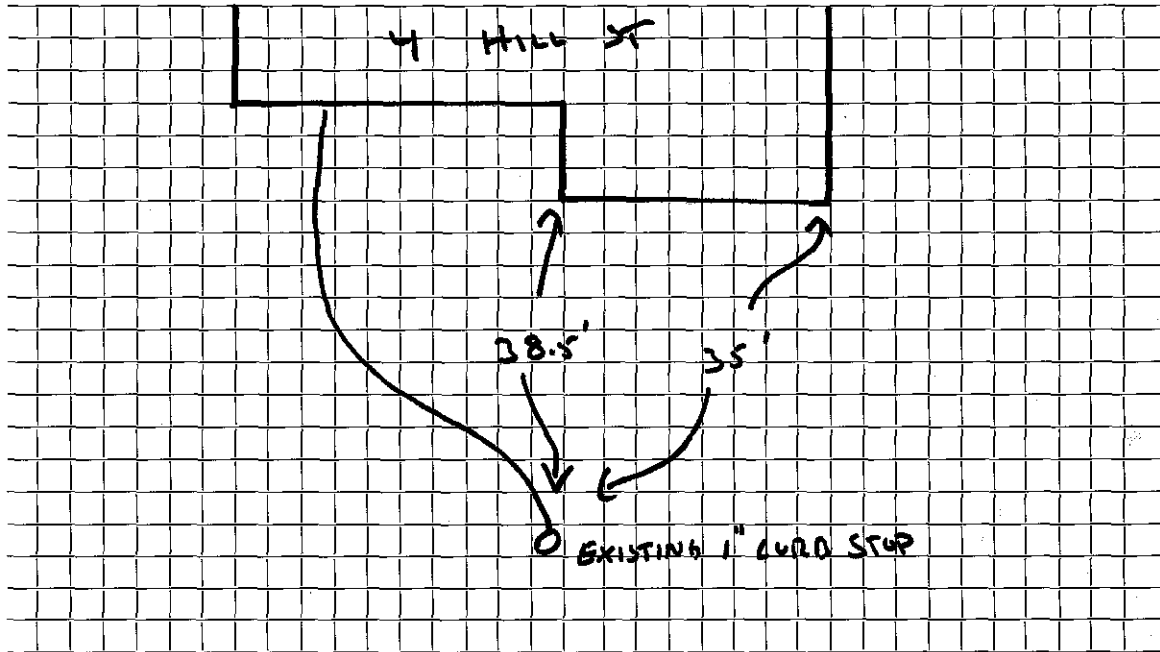

Connection made in HILL Street. Work completed BY CON CONST.

Remarks: CONNECTED TO EXISTING 1\"