

WATER SERVICE RECORD

Name Peter Athens

Service No. 143

Address 40 Hill Street

Location

~~Repair Record~~ - New Service W.O. #8349


MAR 23 1964

Date	Material	Amount	Total	Date	Amount	
12/5/63	Labor	2 42		11-27-63	100 60	
	10% overhead	24	2 66	3-23-64	59 62	
	56' 1" Copper tubing @ .56		31 36		40 78	
	1 1" Cx3/4" I.W.H. Stop & Waste		6 96			
			40 98		NON CHARGE	
				12/5/63	Labor	2 31
					8' 1" Copper tubing @ .56	4 48
					1 1" C. Corp Cock	7 31
					1 1" C. Curb Cock	8 06
					1 Box & Rod	4 90
						27 06

DATE _____

TOWN OF LEXINGTON — BOARD OF PUBLIC WORKS
WATER DIVISION

Sketch of Service Here

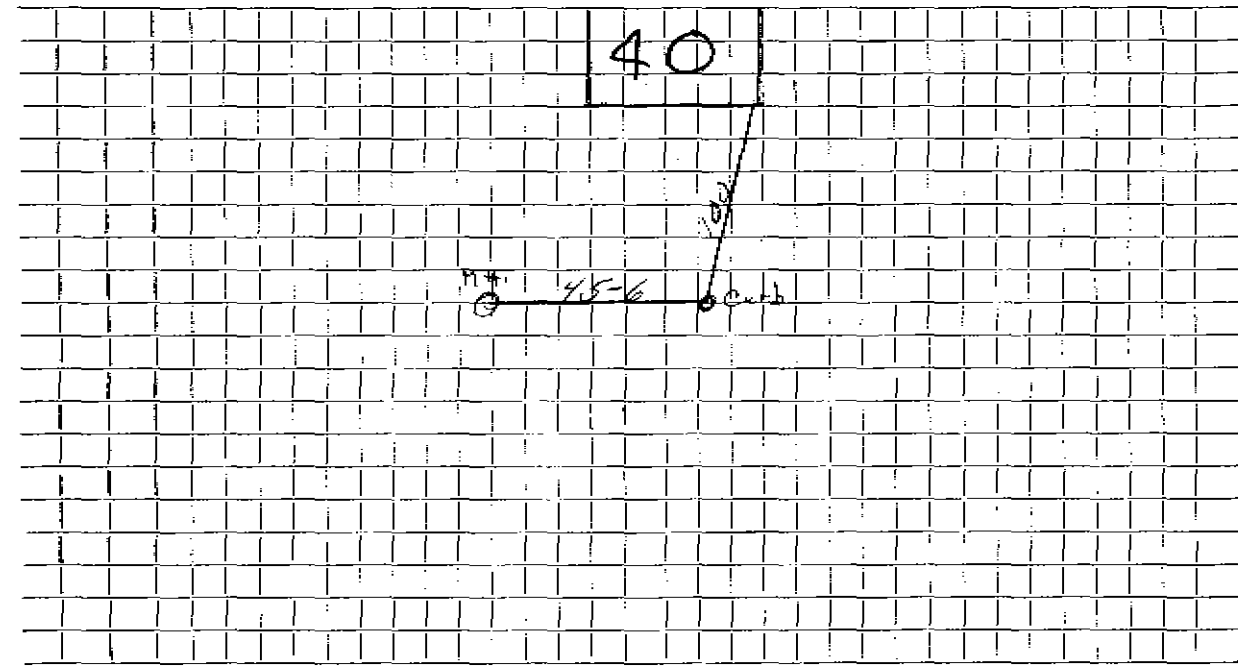

Connection made in Street. Work completed

Remarks:
.....
.....