

Name Arlex Realty Trust Inc.

1468, 1478
Service No. 206

Address 42 Hill Street

6555

Lexington, Mass.

Location 42 Hill Street

Kind of Pipe

Size

Size of Main

~~Repair~~ ~~Renewal~~ New Service

Com. 11-6-50

Location

Date	Material	Amount	Total	Date	Amount
Sept. 1, '50	Labor	3 90	3 90	Aug 7 '50	70 00
	10% Overhead		39		11 11
	60' - 3/4" Copper Tubing @.275	16 50			57 23
	1 - 3/4" C x 1/2" I.W.H. S35W	3 29			No Charge
	Littlefield Shovel 3 hrs. @7.00	21 00		Sept. 1, '50	Labor
	Trucking 1 hr. @.75	75			3 90
	Patching 12 x 3	12 00			18' - 3/4" Copper Tubing @.275
		57 83			4 95
					1 - 3/4" C Corp-cock
					3 15
					1 - 3/4" C x 3/4" C Curb-cock
					3 85
					1 - Box & Rod
					3 35
					1 - 1/2" Straight Tail Piece
					42
					1 - 1/2" Offset Tail Piece
					42
					Littlefield Shovel 2 hrs. @ 17.00
					14 00
					Trucking 1 hr. @.75
					75
	Labor				34 79

Hadley Press, Inc., Lexington

DATE _____

TOWN OF LEXINGTON—BOARD OF PUBLIC WORKS

WATER DIVISION

The undersigned applies for a supply of water at No. _____ St. and hereby agrees to comply with the rules and regulations as now, or at any future time, established by the Board of Selectmen.

Am't. of Estimate \$ _____


Owner _____

Am't. Paid \$ _____

Address _____

Builder _____

Sketch of Service Here

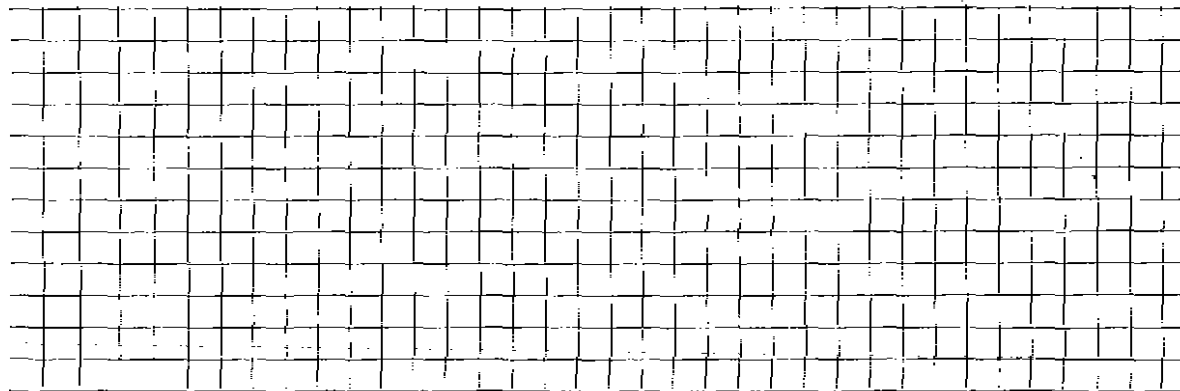

Connection made in _____ Street. Work completed _____ 19

Remarks:

Name Arlex Realty Trust Inc.

1468, 1472
 Service No. 206
 # 6555

Address 42 Hill Street

Lexington, Mass.

Location 42 Hill Street

Kind of Pipe

Size

Size of Main

~~Repair - Renewal~~ New Service

Com. 11-6-50

Location

Date	Material	Amount	Total	Date	Amount
Sept. 1, '50	Labor	3 90	3 90	Aug 7 '50	76 00
	10% Overhead		39		14 17
	60' - 3/4" Copper Tubing @.275	16 50			57 85
	1 - 3/4" C x 1/2" I.W.H. S&W	3 29			No Charge
	Littlefield Shovel 3 hrs. @7.00	21 00		Sept. 1, '50	Labor
	Trucking 1 hr. @.75	75			3 90
	Patching 12 x 3	12 00			18' - 3/4" Copper Tubing @.275
		57 83			4 95
					1 - 3/4" C Corp-cock
					3 15
					1 - 3/4" C x 3/4" C Curb-cock
					3 85
					1 - Box & Rod
					3 35
					1 - 1/2" Straight Tail Piece
					42
					1 - 1/2" Offset Tail Piece
					42
					Littlefield Shovel 2 hrs. @ 17.00
					14 00
					Trucking 1 hr. @.75
					75
	Labor				34 79

Hadley Press, Inc., Lexington

DATE _____

TOWN OF LEXINGTON—BOARD OF PUBLIC WORKS

WATER DIVISION

The undersigned applies for a supply of water at No. _____ St. and hereby agrees to comply with the rules and regulations as now, or at any future time, established by the Board of Selectmen.

Am't. of Estimate \$ _____


Owner _____

Am't. Paid \$ _____

Address _____

Builder _____

Sketch of Service Here

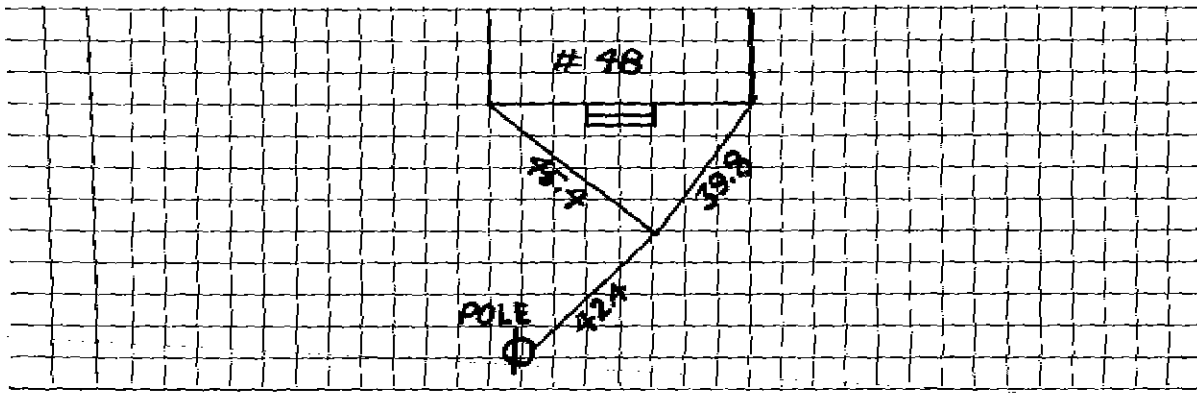

Connection made in _____ Street.

Work completed _____ 19__

Remarks: