

Name Henry Anderson
 Address 48 Hill Street
 Lexington, Mass.

Service No. 173
 # 3910 # 5166

Location 48 Hill Street

Kind of Pipe

Size

Size of Main

~~Repair - Renewal - New Service~~

Com. 11-6-50

Location

Date	Material	Amount	Total	Date	Location	Amount
Aug. 9, 50	Labor	1 30	1 30	July 17, 50	Deposited	30 00
	10% Overhead		13			<u>4 30</u>
	40' - 3/4" Copper Tubing @.23		9 20		No Charge	27 00
	1 - 3/4" C x 1/2" I.W.H. S&V		3 29	Aug. 9, 50	Labor	2 12
	Trucking 1 hr. @.75		75	15' - 3/4" Copper Tubing @.23		3 45
	Patching 10 x 3		10 00	1 - 3/4" C Corp-cock		3 15
			24 67	1 - 3.4" C x 3/4" C Gurb-cock		3 85
				1 - Box & Rd		3 35
				1 - 1/2" Offset Tail Piece		42
				1 - 1/2" Straight Tail Piece		42
				Littlefield Shovel 1 1/2 hrs. @7.00		10 50
				Trucking 1 hr. @.75		<u>75</u>
	Labor					28 01

DATE _____

TOWN OF LEXINGTON—BOARD OF PUBLIC WORKS WATER DIVISION

The undersigned applies for a supply of water at No. _____ St. and hereby agrees to comply with the rules and regulations as now, or at any future time, established by the Board of Selectmen.

Am't. of Estimate \$ _____


Owner _____

Am't. Paid \$ _____

Address _____

Builder _____

Sketch of Service Here

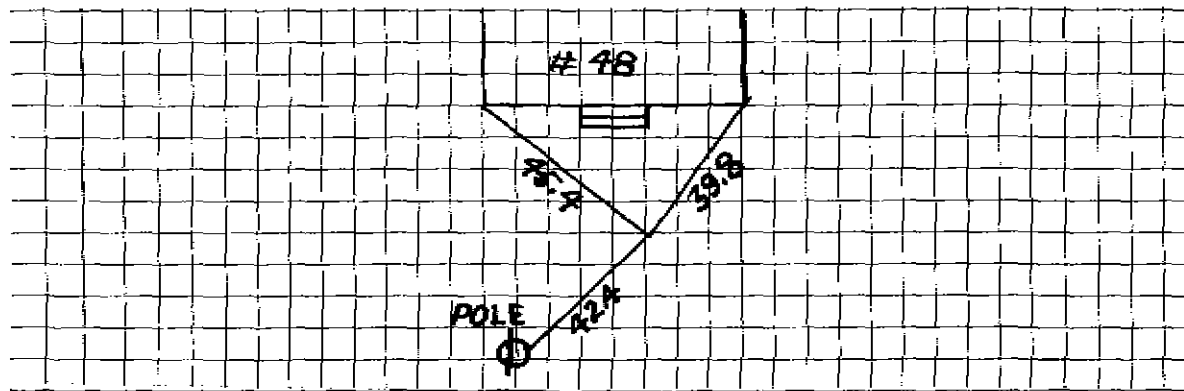

Connection made in _____ Street. Work completed _____ 19__

Remarks: