


TOWN OF LEXINGTON — BOARD OF PUBLIC WORKS

WATER DIVISION

Sketch of Service Here

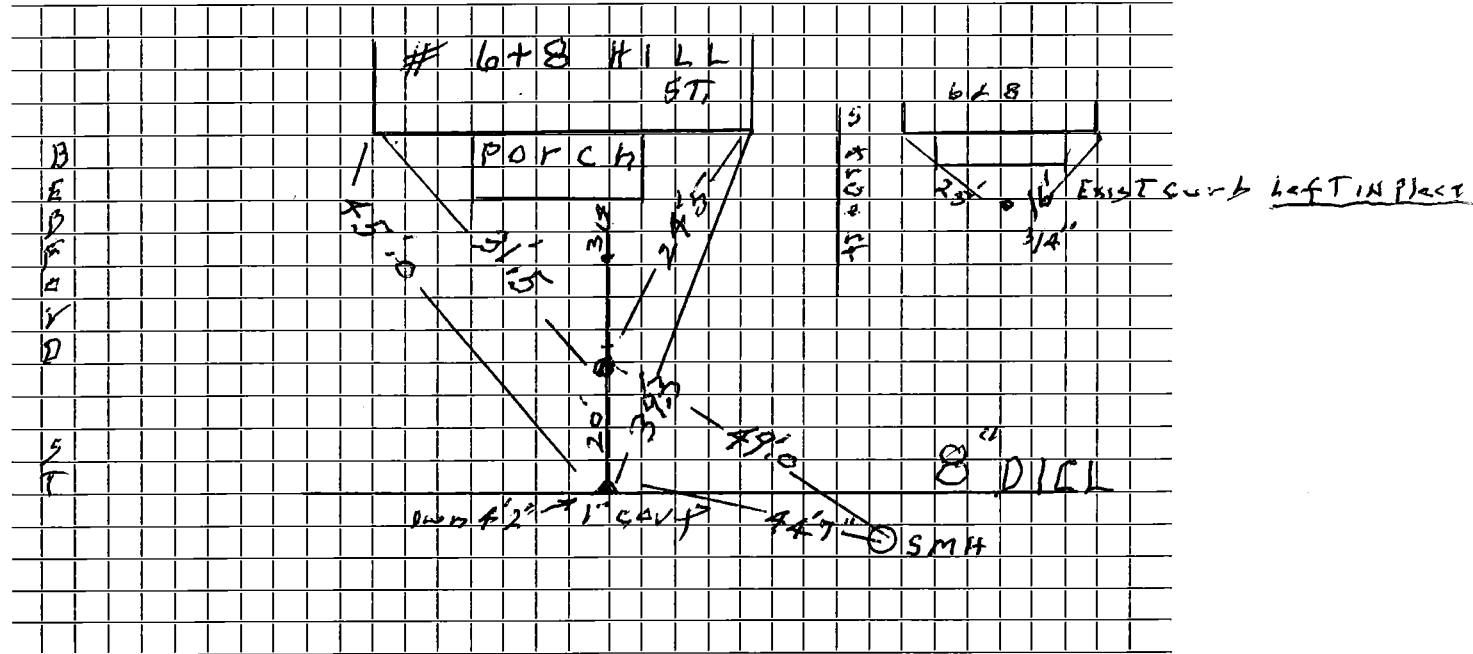

Connection made in Hill St Street. Work completed 2011 Grant

Remarks: Existing 3/4\"/>

.....
