

WATER SERVICE RECORD

#2915

Name A.J. Comeau

Service No. 234

Address 62 Hill Street, Lexington, Mass.

Location Mail to-Old Coach Road, Weston, Mass.

Repair ~~Renewal~~ - New Service

Service was into curb

Com. 11-21-55


Date	Material	Amount	Total	Date	Amount
9/10/55	Labor	1 85		7-19-55 - Deposited	25 00
	10% Overhead	19	2 04	11-21-55 Paid	(16 35
	90'-3/4" Copper tubing @ .384	34 56		Non Charge	41 35
	1-3/4" Cx 1/2" I.W.H. stop & waste	4 00		9/10/55 Labor	---
	1 hr. trucking @ .75	75		1-1/2" straight tail piece	50
			41 35	1-3/8" offset tail piece	50
				8/17/54 34' 3/4 COPPER	1 00
				1 3/4 CURB	
				1 3/4 CORP	
				Box + Rod	

DATE _____

TOWN OF LEXINGTON — BOARD OF PUBLIC WORKS

WATER DIVISION

Sketch of Service Here

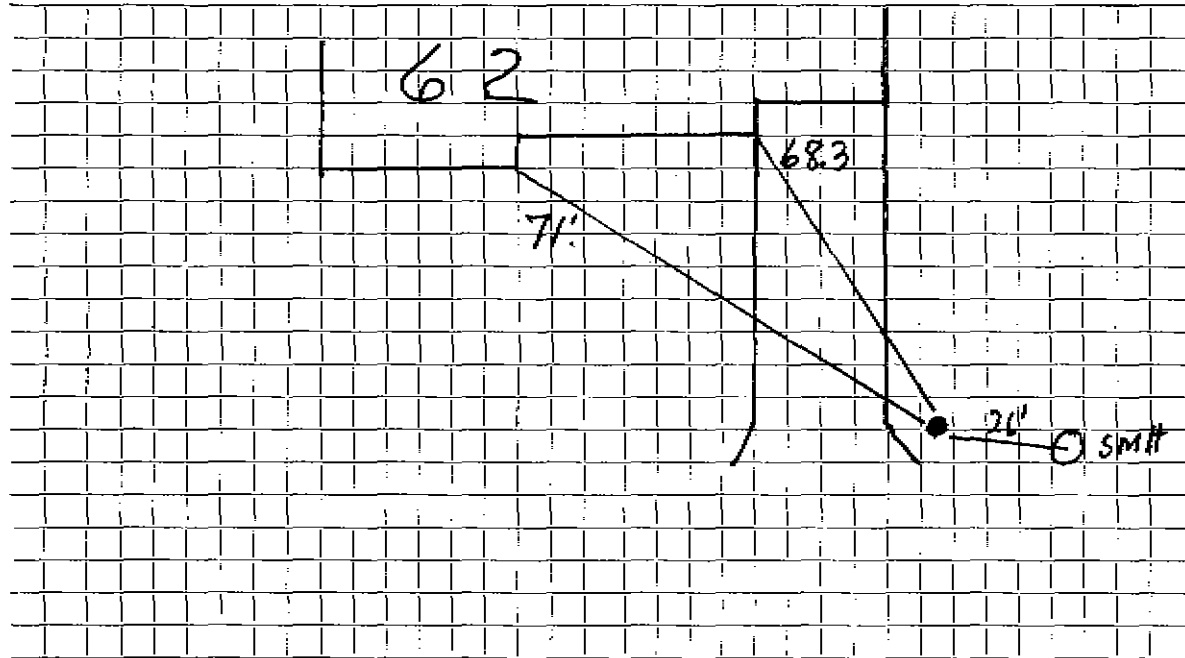

Connection made in _____ Street _____ Work completed _____

Remarks: _____
