

WATER SERVICE RECORD

Name Lexington Const. Co.

Service No. 164

Address 64 Hill St.

Location Lexington

~~REPAIR WORK~~ - New Service

*Com. 8-10-53*

Date	Material	Amount	Total	Date	Amount
7/1/53	Labor	5 70		6-22-53	75 00
	10% overhead	57	6 27	8-10-53	11 60
	90'-3/4" Copper Tubing @.3629		32 66		63 40
	1-3/4" C x 1/2 I.W.H. STOP & WASTE		4 00	7/1/53	7 79
	1-3/4" C x 3/4" C. Union (3 parts)		1 72	20'-3/4" Copper Tubing @.3629	7 26
	1 Hr. Trucking		75	1-3/4" C. Corp-cock	4 33
	Patching 18 x 3		18 00	1-3/4" C x 3/4" C. Curb-cock	4 57
			63 40	1-Box & Rod	3 90
				1-1/2 offset tail piece	50
				1-1/2 straight tail piece	50
	TRENCH DUG BY OWNER			2 2/3 Hr. Littlefield Shovel	37.50 20 00
				1 Hr. Trucking	75
					49 70

*Deposited*  
*Refunded*


NON CHARGE

DATE \_\_\_\_\_

TOWN OF LEXINGTON - BOARD OF PUBLIC WORKS

WATER DIVISION

Sketch of Service Here

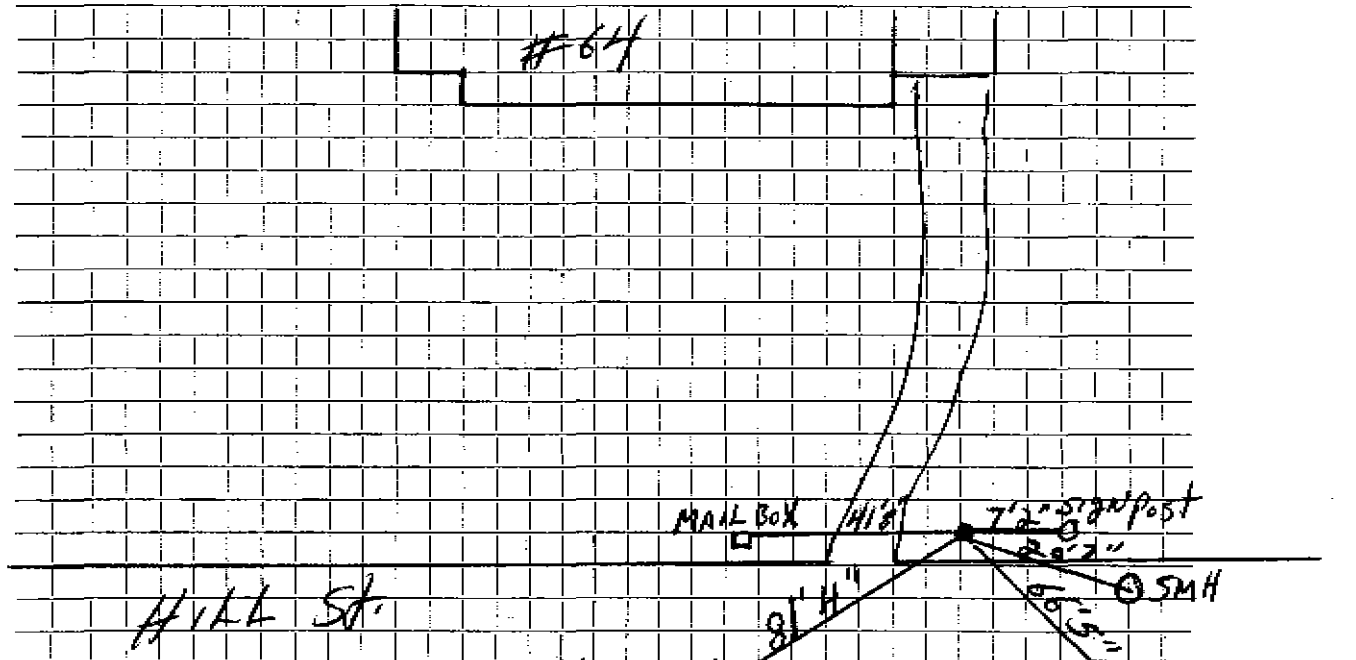

Connection made in ..... Street.  $\frac{47}{35}$   $\phi$  Work completed  $\frac{47}{20}$   $\phi$

Remarks: .....

.....

.....