


Dpw

DATE _____

TOWN OF LEXINGTON — BOARD OF PUBLIC WORKS

WATER DIVISION

Sketch of Service Here

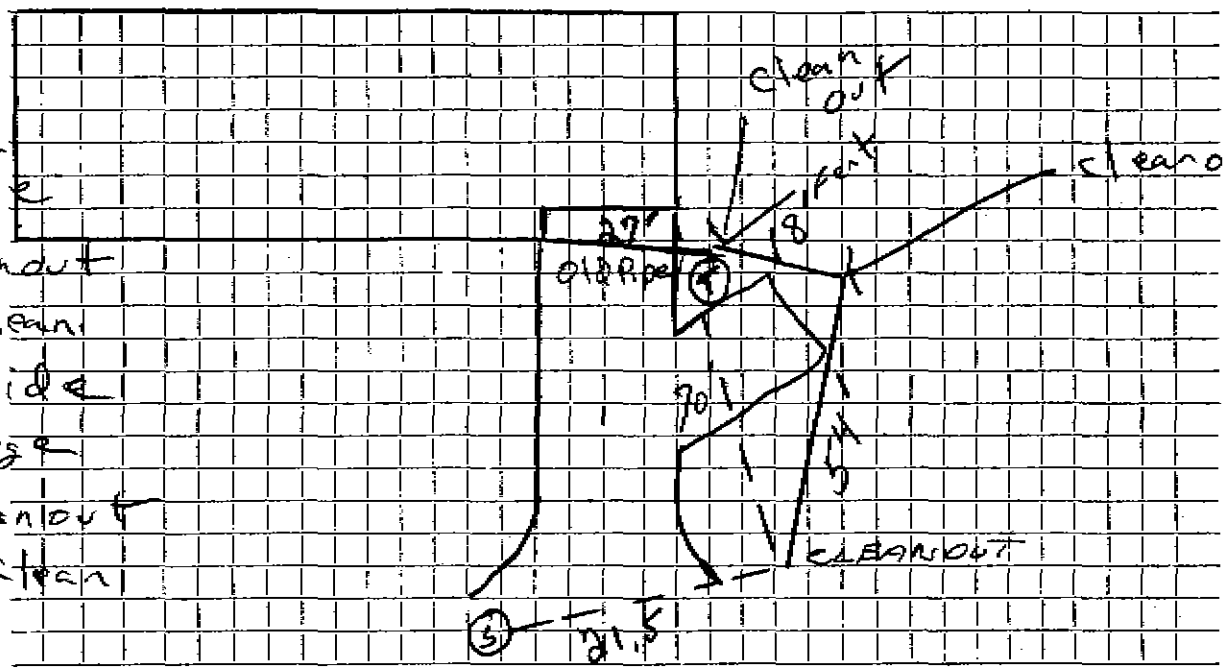

off outside
corner of garage
to First cleanout
19' Second clean
out 46' inside
corner of Garage
to First cleanout
29' Second clean
54'

Connection made in HILL ST. Street. Work completed _____

Remarks: _____

