

Name Anthony Zarella

Service No. 182

#4866

Address 77 Hill Street

Lexington, Mass.

Location 77 Hill Street

Kind of Pipe

Size

Size of Main

~~Repair-Renewal~~—New Service

Com. 11-6-50

Location

Date	Material	Amount	Total	Date	Amount
Aug. 9, '50	Labor	3 80	3 80	July 24 '50	5 00
	10% Overhead		38		2
	14' - 3/4" Copper Tubing @.275	12 10			40 32
	1 - 3/4" C x 1/2" I.W.H. S&W	3 29		Aug. 9, '50	6 40
	Littlefield Shovel 2 hrs. @7.00	14 00		12' - 3/4" Copper Tubing @.275	3 30
	Trucking 1 hr. @.75	75		1 - 3/4" C Corp-cock	3 15
	Patching 6 x 3	6 00		1 - 3/4" C x 3/4" C Curb-cock	3 85
			40 32	1 - Box & Rod	3 35
				1 - 1/2" Offset Tail Piece	42
				1 - 3/8" Straight Tail Piece	42
				Littlefield Shovel 1 hr. @ 7.00	7 00
				Trucking 1 hr. @.75	75
	Labor				28 64

Requested
No Charge

Hadley Press, Inc., Lexington

DATE _____

TOWN OF LEXINGTON - BOARD OF PUBLIC WORKS

WATER DIVISION

The undersigned applies for a supply of water at No. _____ St. and hereby agrees to comply with the rules and regulations as now, or at any future time, established by the Board of Selectmen.

Am't. of Estimate \$ _____


Owner _____

Am't. Paid \$ _____

Address _____

Builder _____

Sketch of Service Here

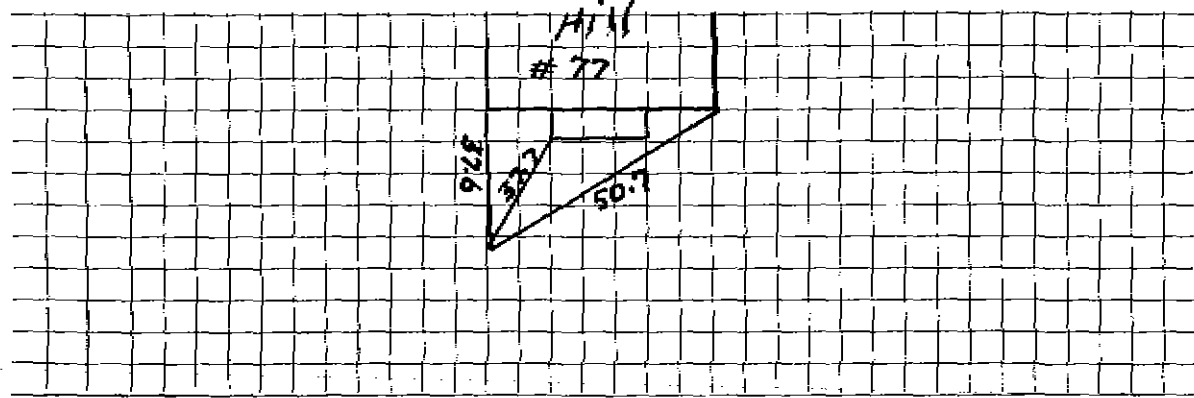

Connection made in _____ Street.

Work completed _____ 19

Remarks: