

Owner:
Name Sherman Hardy

Address 1 Belfry Terrace

80 Hill St.

Send bill to:
Custance Bros.
Lexington, Mass.

Service No. ~~10~~ 1279
2685

Location 80 Hill Street

Kind of Pipe

Size

Size of Main

~~Repair~~ ~~Renewal~~ ~~New Service~~

Location

Date	Material	Amount	Total	Date	Location	Amount
5/6/40	Labor: 7 hrs. @ 60¢		4 20	June 12, 1940 <i>R Paid</i>		39 03
<i>Com 7/20/40</i>	10% Overhead		42			
	100' 1" Copper tubing @ 19¢		19 00			
	1 1" Cx3/4" I.W.H. Stop & Waste		2 25			
	1 1" C. Union (3 part)		1 00			
	Trucking, 2 hrs. @ 75¢		1 50			
	Trench repairs		10 66			
			<u>39 03</u>			
	Labor					

DATE April 30, 1940

TOWN OF LEXINGTON—BOARD OF PUBLIC WORKS
WATER DIVISION

The undersigned applies for a supply of water at No. 70 Hill St. and hereby agrees to comply with the rules and regulations as now, or at any future time, established by the Board of Selectmen.

Am't. of Estimate \$ 50.00

Owner Sherman Hardy


Am't. Paid \$ _____

Address 1 Belfry Terrace,

Builder Custance Bros.

Lexington, Mass.

Sketch of Service Here

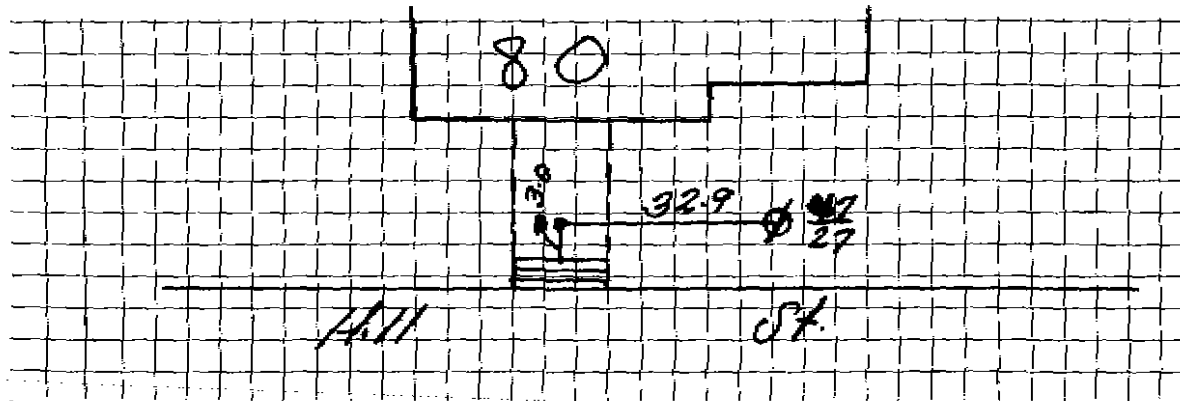

Connection made in _____ Street. Work completed _____ 19

Remarks: