

Name Walter Black  
 Address 83 Hill Street  
 Lexington, Mass.

Service No. 2 2765  
 \$5695

Location 83 Hill Street

Kind of Pipe

Size

Size of Main

~~Repair~~ New Service

Com. 2-21-49

Location

Date	Material	Amount	Total	Date	Amount
Dec. 22, '48	Labor	12 70	12 70	Jan 3, '49	35 00
Dec. 23, '48	Labor	10 00	10 00	Jan 13, '50	6 86
	10% Overhead		2 27	4 10-51	7 22
	33' - 3/4" Copper Tubing @.27		8 91		1 22
	1 - 3/4" C x 1/2" I.W.H. S&W		3 15		43 78
	Hough Loader 2 hrs. @3.00		6 00	Dec. 23, '48	30 92
	Trucking 1 hr		75	8' - 3/4" Copper Tubing @.27	2 16
			43 78	1 - 3/4" C Corp-cock	3 00
				1 - 3/4" x 3/4" C Curb-cock	5 68
				1 - Box & Rod	3 55
				1 - 1/2" Straight Tail Piece	30
				1 - 1/2" Offset Tail Piece	30
				Compressor 2 hrs. @1.75	3 50
				Trucking 1 hr. @.75	75
	Labor				48 16

Deposited  
 Cash  
 Paid

Non-Charge

\* 10-16-51 Paid 11.17 -- 9.25 refunded  
 1.92 applied to this acct.  
 11.17

DATE \_\_\_\_\_

TOWN OF LEXINGTON - BOARD OF PUBLIC WORKS  
**WATER DIVISION**

The undersigned applies for a supply of water at No..... St. and hereby agrees to comply with the rules and regulations as now, or at any future time, established by the Board of Selectmen.

Am't of Estimate \$.....


Owner .....

Am't Paid \$.....

Address .....

Builder .....

Sketch of Service Here

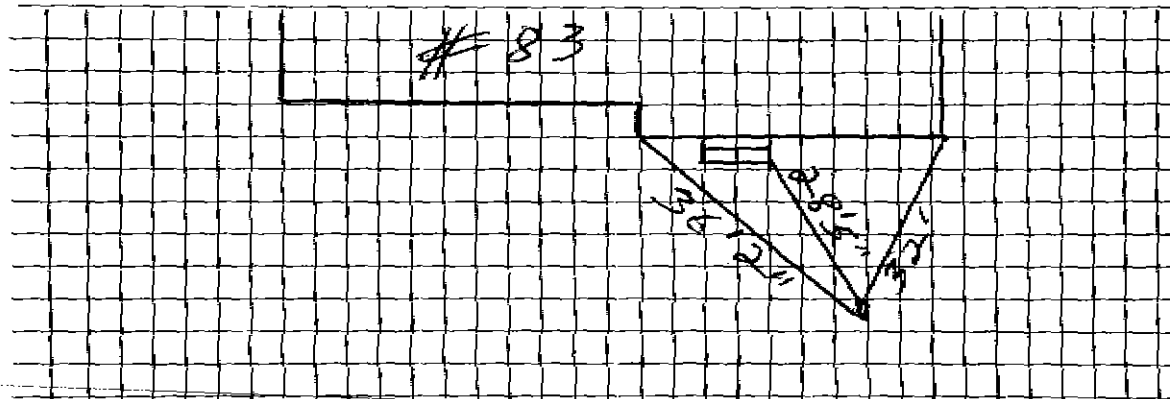

Connection made in ..... Street.

Work completed .....19

Remarks: