




Date: 6/8/22

TOWN OF LEXINGTON - BOARD OF PUBLIC WORKS  
WATER DIVISION

SKETCH OF SERVICE HERE

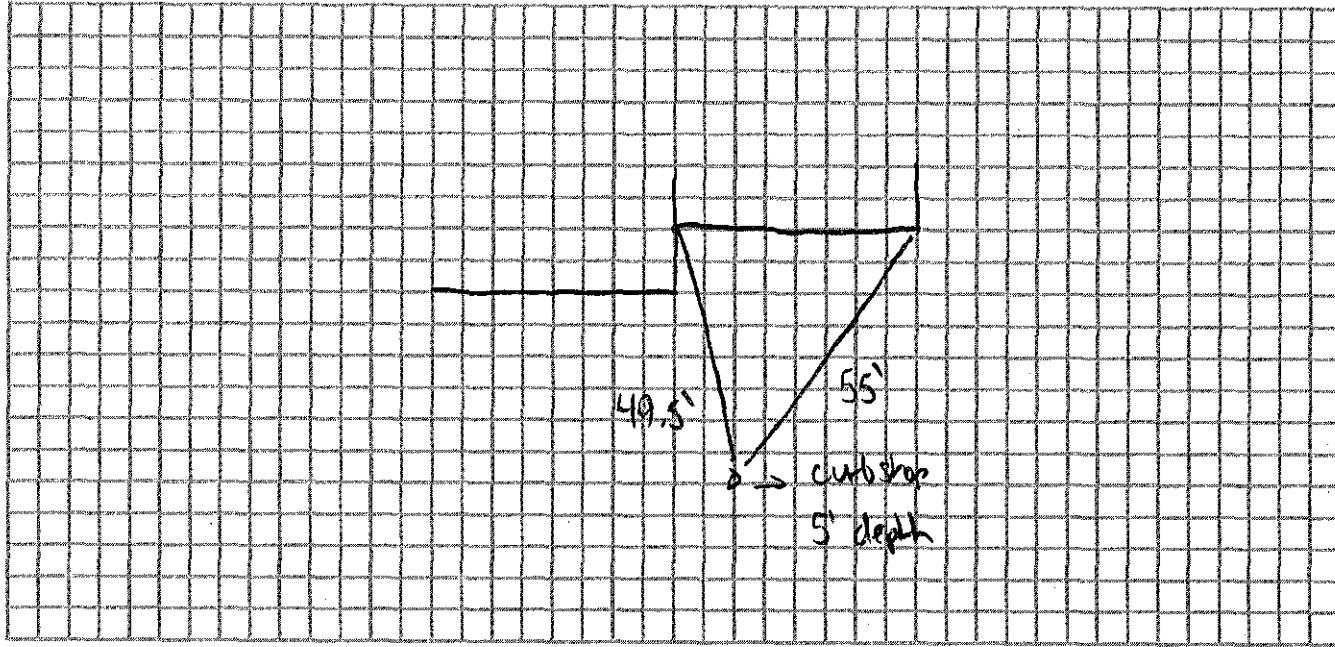

Connection made in: HILLTOP AVG

Street.

Work completed:

Remarks: INSTALLED By S & T FROTTON, INC.