


DATE _____

TOWN OF LEXINGTON — BOARD OF PUBLIC WORKS

WATER DIVISION

Sketch of Service Here

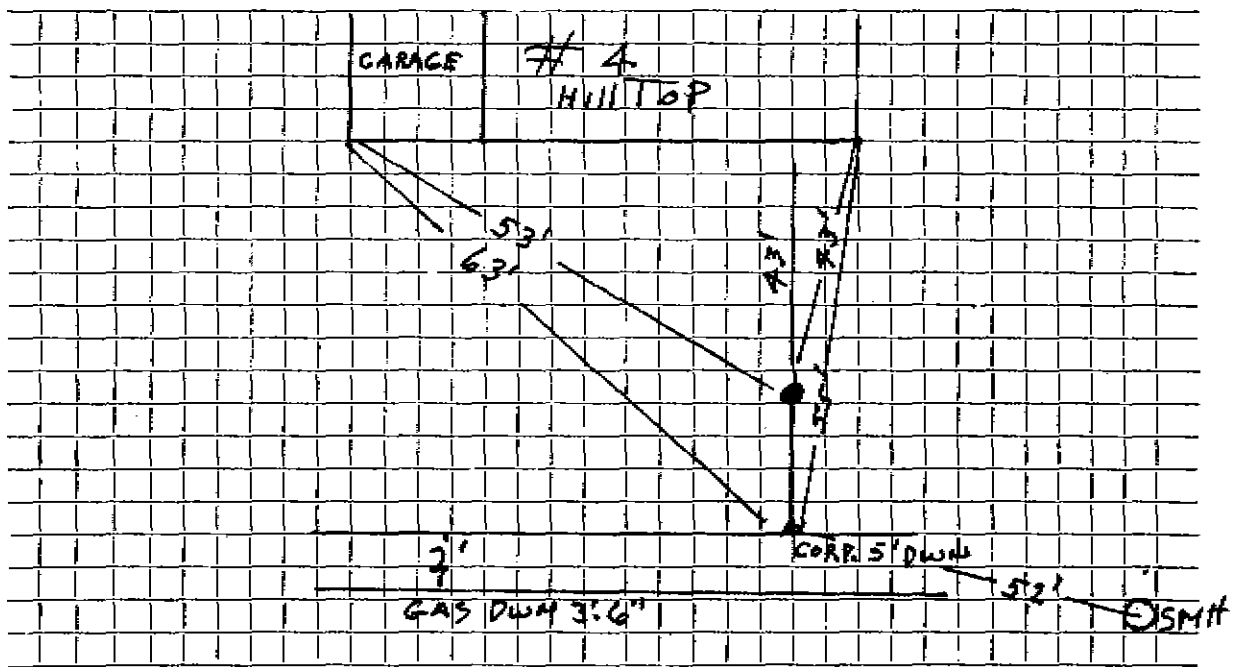

Connection made in *Hilltop*..... Street. Work completed *7/15/99*.....

Remarks:

.....

.....