

WATER SERVICE RECORD

Name Scott Properties

Service No. 46

Address 5 Hilltop Ave

Location W.O. #1295

Repair—Renewal—New Service  Office Bros. # 2419

APR 8 1974


Date	Material	Amount	Total	Date	Amount	
10-15-73	37' - 3/4" Copper			9-14-73	Deposit	125.00
10-4-73	Labor 66.00			4-8-73	Paid by SHC #117	80.30
10-19-73	" 10% O.H. 31.43	97.43	107.17			<u>205.30</u>
	35' 3/4" Copper pipe @ .98 ft.		34.30			
	1 3/4" Corporation		9.57			
	1 3/4" Curb Stop		11.32			
	1 3/4" 3 part union		3.87			
	1 Box & Rod		7.34			
	1/2 ton Cold Patch		4.13			
	2 1/2 hr. Trucking @3.00		7.50			
	1 hr. Roller @2.00		2.00			
	1 hr. Compressor @5.00		5.00			
	2 hrs. Backhoe @6.50		13.00			
			205.20			

DATE \_\_\_\_\_

TOWN OF LEXINGTON — BOARD OF PUBLIC WORKS

**WATER DIVISION**

Sketch of Service Here

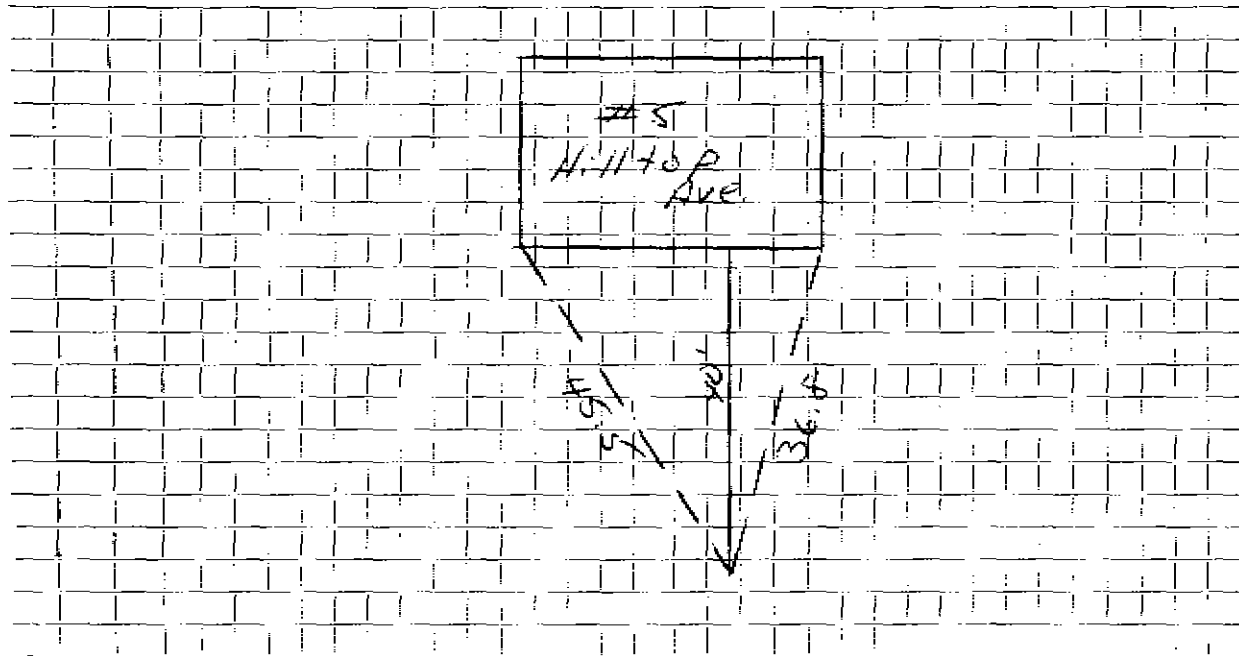

Connection made in ..... Street. Work completed .....

Remarks: .....

.....

.....