
WATER SERVICE RECORD Name Service No. 6 Hilltop Address Location Repair-Renewal-New Service Material Total Date Date Amount outside 14'-3/4 Copper 6/6/88 1-3/4 Corp Adp. Style 138 6" C.L. Nipple 3/4" Curb Stop 14 | yds. Gravel PEPAIR 1-3/4 NIPPLE 40'-1"WATER c/c UNION

DAT	E	 	

TOWN OF LEXINGTON - BOARD OF PUBLIC WORKS

WATER DIVISION

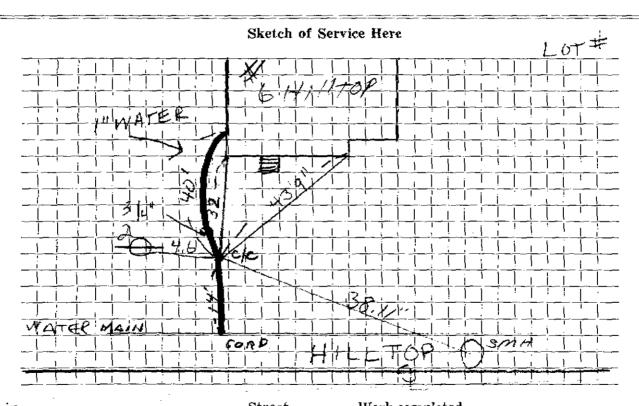

Connection made in Street.	work completed
Remarks: .,	