

Water Service Record

Name

Service No.

Address

9 Hilltop Ave

Location


Repair Renewal New Service

Date	Material	Amount	Total	Date		Amount
7/2020	1" type K copper					
	1" curb stop					
	open right					
	Camb brass					
	Buffalo Box					

Date: 7/2020

TOWN OF LEXINGTON - BOARD OF PUBLIC WORKS
WATER DIVISION

SKETCH OF SERVICE HERE

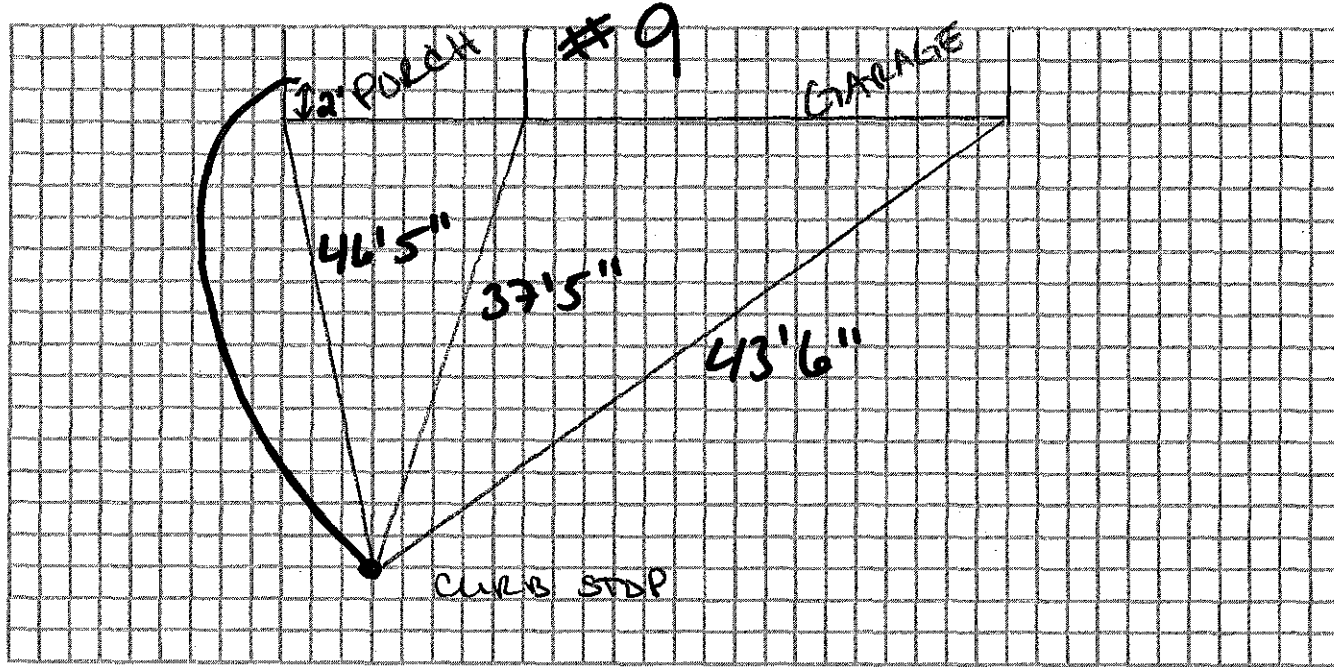

Connection made in: Hilltop Ave Street: Work completed:

Remarks: