
WATER SERVICE RECORD

| Name | | | Service No. | | | | |
|-------------------|------------------------|----------------------|-------------------|--|---------------------------------------|--|--|
| Addres | s 9 Hilltop | | | | | | |
| Locatio | n | | | | | | |
| Repair | -Renewal-New Service | | | | | | |
| Date | Material | Amount | Total | Date | | Amount | |
| | outside: | | | | Foside | | |
| Checked 4-8-92 | Outside: 3/4 Copper | | <u> </u> | | Enside C.L. Pipe | ! | |
| <u>'</u> | | · | - | # | | <u> </u> | |
| | - | <u> </u> | - | - | - | | |
| | | | ! — — — — — | | - | | |
| | _ + | | | | | | |
| | | <u> </u> | <u> </u> | " - | | ļ | |
| - | | · | | | ! | | |
| | - | | ! | + | | | |
| | | └── ── ── | : | - - | | | |
| - | | - + | | - | | | |
| | | | | · | | | |
| | | | · | 1 | | | |
| - | - | | <u> </u> | -# - - | | - - - | |
| <u> </u> | | +-++ | ļ | <u> </u> | · · · · · · · · · · · · · · · · · · · | + | |
| | | | | ╣ | | - ; | |

TOWN OF LEXINGTON - BOARD OF PUBLIC WORKS

WATER DIVISION

Sketch of Service Here

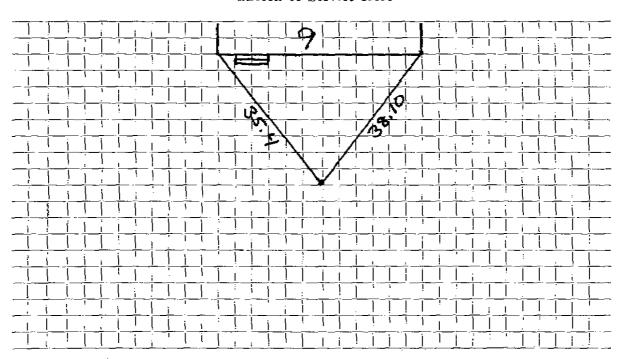

| Connection made in St | treet. | Work completed |
|---------------------------------|--------|---|
| Remarks: Checked For Copper 7:8 | .92 | |
| | | *************************************** |