

WATER SERVICE RECORD

Name George Bilafer

Service No. 105

Address 10 Hillcrest Ave.,

7031

Location (Mail: 6 Hathaway Cir., Arlington, Mass.)

~~Repair~~ ~~XXXXXX~~ - New Service

Case 11-13-61


Date	Material	Amount	Total	Date	Amount
8/4/61	Labor	2 15		7-24-61	Deposit 50 00
	10% O.H.	22	2 37	11-13-61	Refund 14 69
					35 31
	58' 3/4" Copper Tubing @ /42		24 36		
	1 3/4" Cx 1/2 IWH Stop & Waste		6 17	8/4/61	Labor 1 77
	1 3/4" C3 part & Union		2 41		10 3/4" Copper Tubins @.42 4 20
			35 31		1 3/4" CCurb Cock 6 28
					1 3/4" C Corp Cock 4 91
					1 Box & Rod 4 90
					1 1/2 Straight Tailpiece 50
					1 1/2 Offset Tailpiece 50
					23 06

TOWN OF LEXINGTON — BOARD OF PUBLIC WORKS

WATER DIVISION

Sketch of Service Here

10

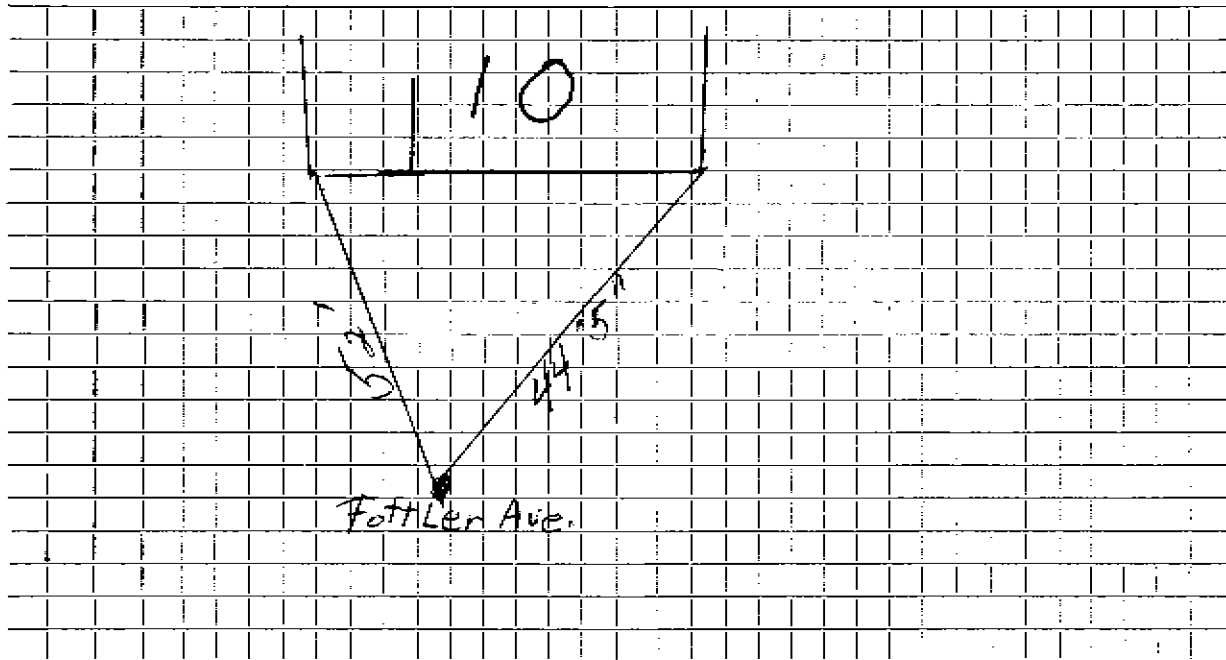

Connection made in Street. Work completed

Remarks:

.....
.....