

WATER SERVICE RECORD

Name Leland Const. Co.

Service No. 175

Address 14 Hillcrest Ave.

Location Lexington

~~Repair - Renewal~~ - New Service

0
Am. 9-29-52

Date	Material	Amount	Total	Date	Amount
8/29/52	Labor	5 32		8-19-52	Deposited 50 00
	10% Overhead	53	5 85	9-29-52	Refunded 16 14
	39' - 3/4" Copper tubing @.34	13 26			<u>NON CHARGE</u> 9 26
	1 - 3/4" C x 1/2 I.W.H. stop & waste	4 00		8/29/52	Labor 5 33
	1 hr. Littlefield shovel	7 00			10' - 3/4" Copper tubing @.34 3 40
	1 hr. Allis Chalmers	3 00			1 - 3/4" C. Corp-cock 4 33
	1 hr. trucking	75			1 - 3/4" C x 3/4" C. curb-cock 4 67
			33 86		1 box and rod 3 90
					1 - 1/2 offset tail piece 50
					1 - 1/2 straight tail piece 50
					1 hr. Littlefield shovel 7 00
					1 hr. trucking 75
					<u>30 38</u>
				7/22/68	MOVE BACK WATER
					1 3/4 Curb


DATE _____

TOWN OF LEXINGTON — BOARD OF PUBLIC WORKS

WATER DIVISION

Sketch of Service Here

#14

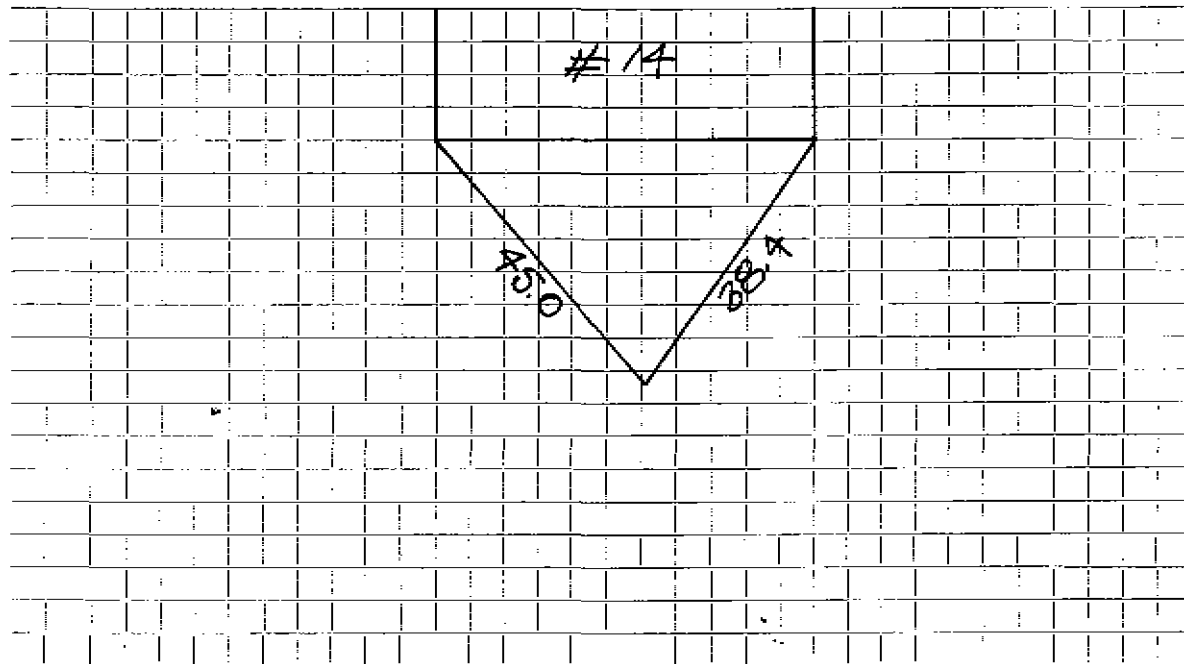

Connection made in Street. Work completed

Remarks:

.....

.....