

Name Edwin Banks
 Address 15 Hillcrest Avenue
 Lexington, Mass.

Service No. 1511

Location 15 Hillcrest Avenue

Kind of Pipe

Size

Size of Main

~~Repair~~ ~~Overhaul~~ New Service

Location

Date	Material	Amount	Total	Date	Location	Amount
Nov. 5, '48	Labor	17 90	17 90	Oct 21 '48	Deposited	50 00
	10% Overhead		1 79	Dec 31 '48	Refunded	11 23
	36' - 3/4" Copper Tubing @ .255	9 18	9 18		Non-Charge	35 77
	1 - 3/4" C x 1/2" I.W.H. S&W	3 15	3 15	Nov. 5, '48	Labor	17 90
	Town Shovel 1 hr. @ 3.00	3 00	3 00		40' - 3/4" Copper Tubing @ .255	10 20
	Trucking 1 hr. @ .75		75		1 - 3/4" Corp-cock	3 00
			35 77		1 - 3/4" C x 3/4" C urb-cock	3 68
					1 - Box & Rod	3 55
					Town Shovel 1 hr. @ 3.00	3 00
					1 - 1/2" Offset Tail Piece	30
					1 - 1/2" Straight Tail Piece	30
					Trucking 1 hr. @ .75	75
	Labor					42 68

TOWN OF LEXINGTON - BOARD OF PUBLIC WORKS

WATER DIVISION

The undersigned applies for a supply of water at No. St. and hereby agrees to comply with the rules and regulations as now, or at any future time, established by the Board of Selectmen.

Am't of Estimate \$.....

Owner

Am't Paid \$.....


Address

Builder

.....

Sketch of Service Here

#15

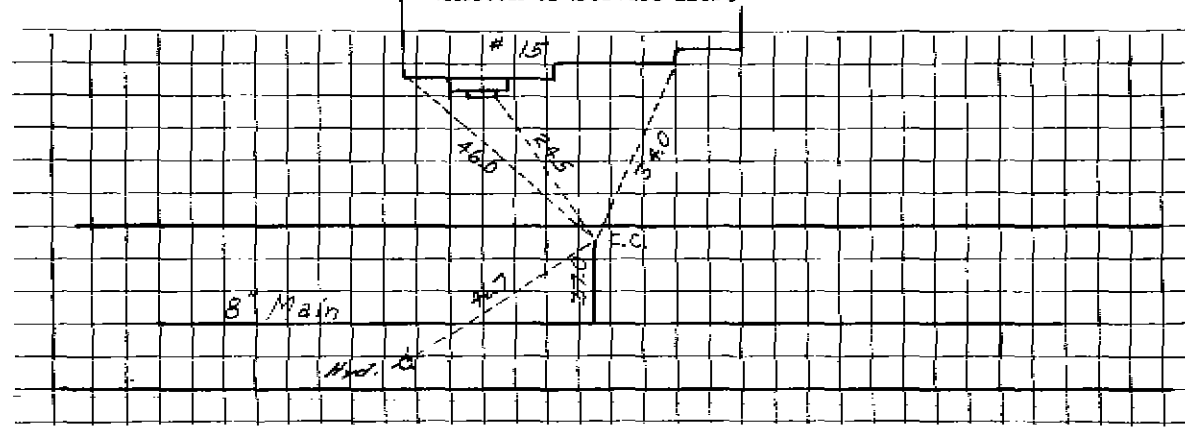

Connection made in Street.

Work completed19

Remarks: