

WATER SERVICE RECORD

Name Leland Const. Co

Service No. 174

Address 16 Hillcrest Ave.

Location Lexington

Repair ~~Remarks~~ - New Service

*Com. 9-29-52*

Date	Material	Amount	Total	Date	Amount
8/29/52	Labor	5 32		8-19-52	50 00
	10% Overhead	53	5 85	9-29-52	14 00
	44' - 3/4" Copper tubing @ .34		14 96		<u>NON CHARGE</u>
	1 - 3/4" C x 1/2 I.W.H. stop & waste		4 00	8/29/52	Labor
	1 hr. Littlefield shovel		7 00		11' - 3/4" Copper tubing @ .34
	1 hr. Allis Chalmers		3 00		1 - 3/4" C. Corp-cock
	1 hr. trucking		75		1 - 3/4" C x 3/4" C. Curb-cock
			35 56		1 Box and Rod
					1 - 1/2 offset tail piece
					1 - 1/2 straight straight tail piece
					1 hr. Littlefield shovel
					1 hr. trucking
					30 72
				8/22/68	Move Back 4 1/2'
					3/4 Curb


DATE \_\_\_\_\_

TOWN OF LEXINGTON — BOARD OF PUBLIC WORKS

**WATER DIVISION**

Sketch of Service Here

#16

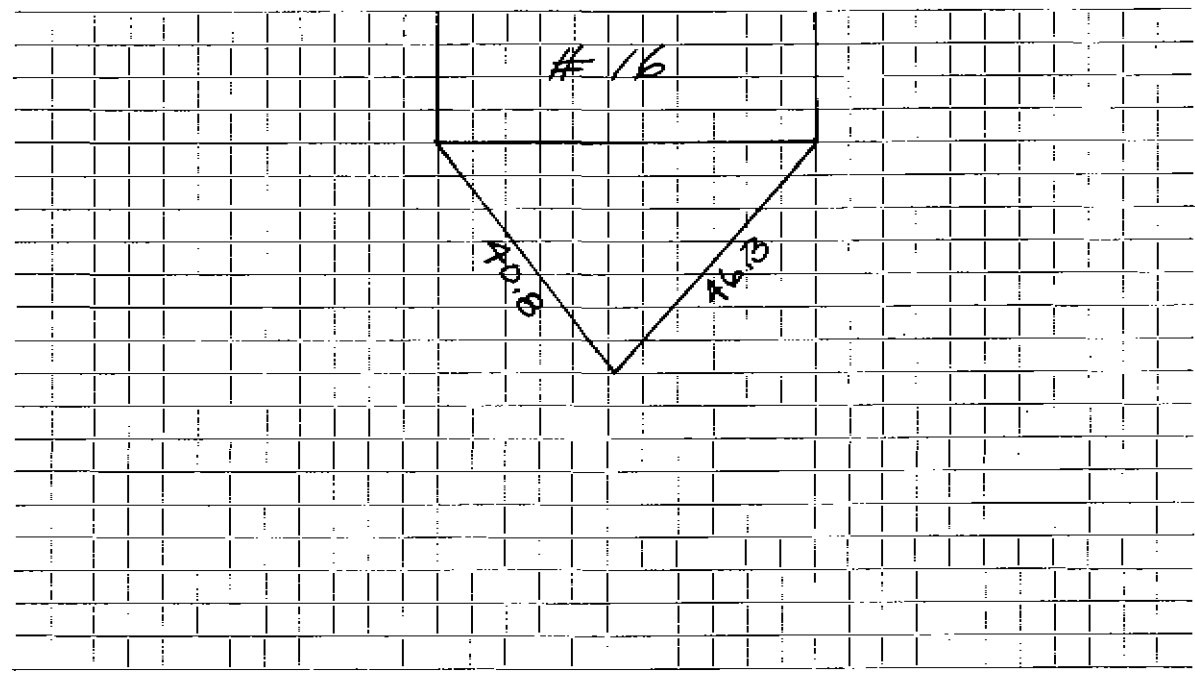

Connection made in ..... Street.      Work completed .....

Remarks: .....  
.....  
.....