

Name Lawrence Selfridge

Service No. #1731

Address 19 Hillcrest Ave.

Lexington, Mass.

Location

Kind of Pipe

Size

Size of Main

~~Repair - Renewal~~ New Service

Location

Date	Material	Amount	Total	Date	Amount
Oct. 16, '48	Labor	2 30	2 30	Oct. 11, '48	35 00
	10% Overhead		23	Mar 31 '48	6 89
	25'-3/4" Copper Tubing @ .255	6 38	6 38		28 13
	1-3/4" C x 1/2" I.W.H. S & W	3 15	3 15	Oct. 16, '48	7 64
	1-3/4" C x 3/4" C. Union (3 pts.)	1 32	1 32	35'-3/4" Copper Tubing @ .255	8 93
	2 hrs. Littlefield Shovel	14 00	14 00	1-3/4" C. Corp. cock	3 00
	1 hr. Trucking	75	75	1-3/4" C x 3/4" C. Curb-cock	3 68
			28 13	1- Box & Rod	3 55
				2 hrs. Littlefield Shovel	14 00
				1-1/2" Offset Tail Piece	30
				1-1/2" Straight Tail Piece	30
				1 hr. Trucking	75
	Labor				42 15

Disputed
Refunded
Non-Charge

Hadley Press, Inc., Lexington

DATE _____

TOWN OF LEXINGTON—BOARD OF PUBLIC WORKS

WATER DIVISION

The undersigned applies for a supply of water at No. _____ St. and hereby agrees to comply with the rules and regulations as now, or at any future time, established by the Board of Selectmen.

Am't. of Estimate \$ _____

Owner _____


Am't. Paid \$ _____

Address _____

Builder _____

Sketch of Service Here

#19

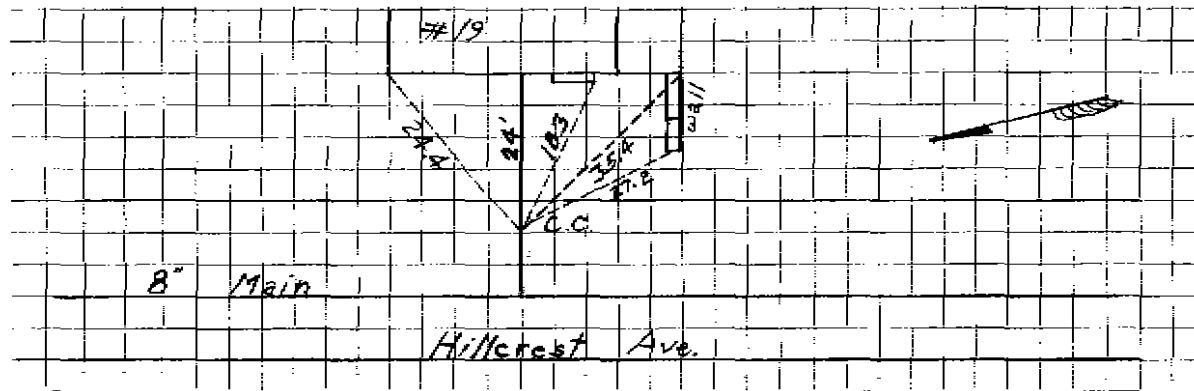

Connection made in _____ Street.

Work completed _____ 19

Remarks: