

WATER SERVICE RECORD

#6200

Name Leland Const. Co.

Service No. 176

Address 20 Hillcrest Ave.

Location Lexington

Repair ~~Renew~~ ~~Alter~~ New Service

Am. 9-29-52

Date	Material	Amount	Total	Date	Amount
8/24/52	Labor	5 32		8-19-52 Deposited	50 00
	10% Overhead	53	5 85	9-29-52 Refund	(14 11)
	45' - 3/4" Copper tubing @ .34		15 30		NON CHARGE
	1 - 3/4 C x 1/2 I.W.H. stop & waste		4 00	8/29/52 Labor	5 33
	1 hr. Littlefield shovel		7 00	12' - 3/4" Copper tubing @ .34	4 08
	1 hr. Allis Chalmers		3 00	1 - 3/4" C. Corp-cock	4 33
	1 hr. trucking		75	1 - 3/4" C x 3/4 C. curb-cock	4 67
			35 90	1 Box and Rod	3 90
				1 - 1/2 offset tail piece	50
				1 - 1/2 straight tail piece	50
				1 hr. Littlefield shovel	7 00
				1 hr. trucking	75
					31 06


DATE _____

TOWN OF LEXINGTON — BOARD OF PUBLIC WORKS

WATER DIVISION

Sketch of Service Here

#20

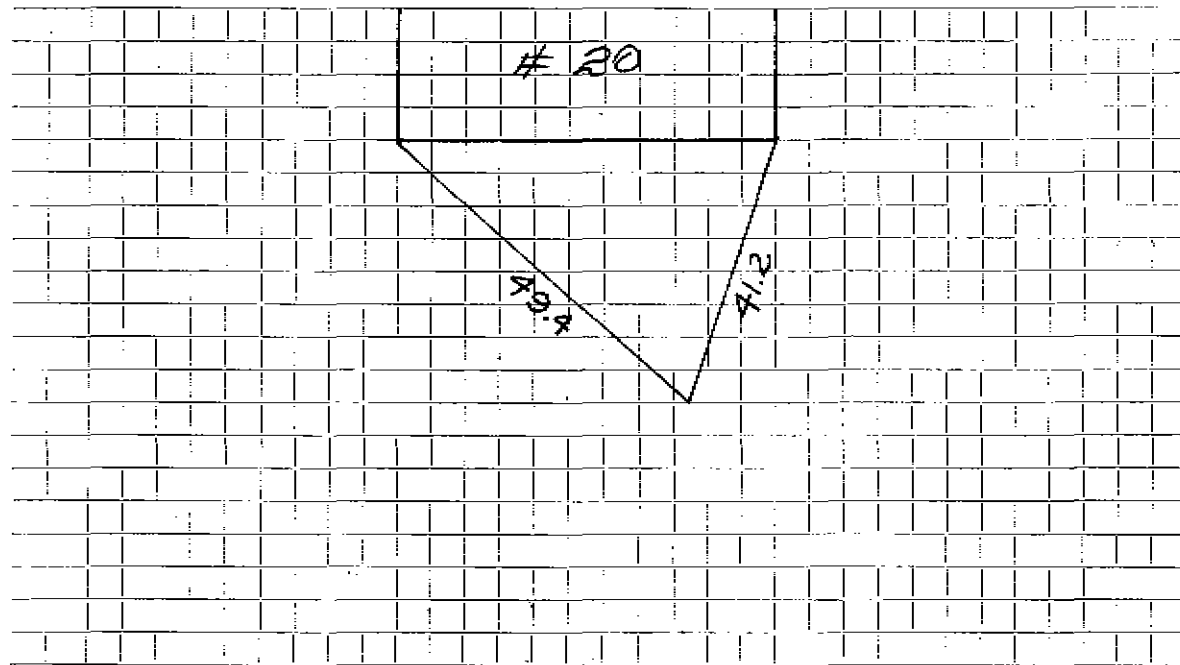

Connection made in Street: Work completed

Remarks :

.....

.....