

WATER SERVICE RECORD

1086

Service No. 177

Name Leland Const. Co.

Address 24 Hillcrest Ave.

Location Lexington

Repair ~~General~~ - New Service

*Com. 9-29-52*

Date	Material	Amount	Total	Date	Amount
8/29/52	Labor	5 32		5-19-52	<i>Deposited</i>
	10% Overhead	53	5 85	9-29-52	
	47' - 3/4" Copper tubing@.34		15 98	8/29/52	NON CHARGE
	1 - 3/4" C x 1/2 I.W.H. stop&waste	4 00		10' - 3/4" Copper tubing@.34	5 33
	1 hr. Littlefield shovel		7 00	1 - 3/4" C. Corp-cock	3 40
	1 hr. Allis Chalmers		3 00	1 - 3/4" C x 3/4" C. curb-cock	4 33
	1 hr. trucking		75	1 box and rod	4 67
			36 58	1 - 1/2 offset tail piece	3 90
				1 - 3/4 straight tail piece	50
				1 hr. Littlefield shovel	7 00
				1 hr. trucking	75
					30 38


DATE \_\_\_\_\_

TOWN OF LEXINGTON — BOARD OF PUBLIC WORKS

**WATER DIVISION**

Sketch of Service Here

#24

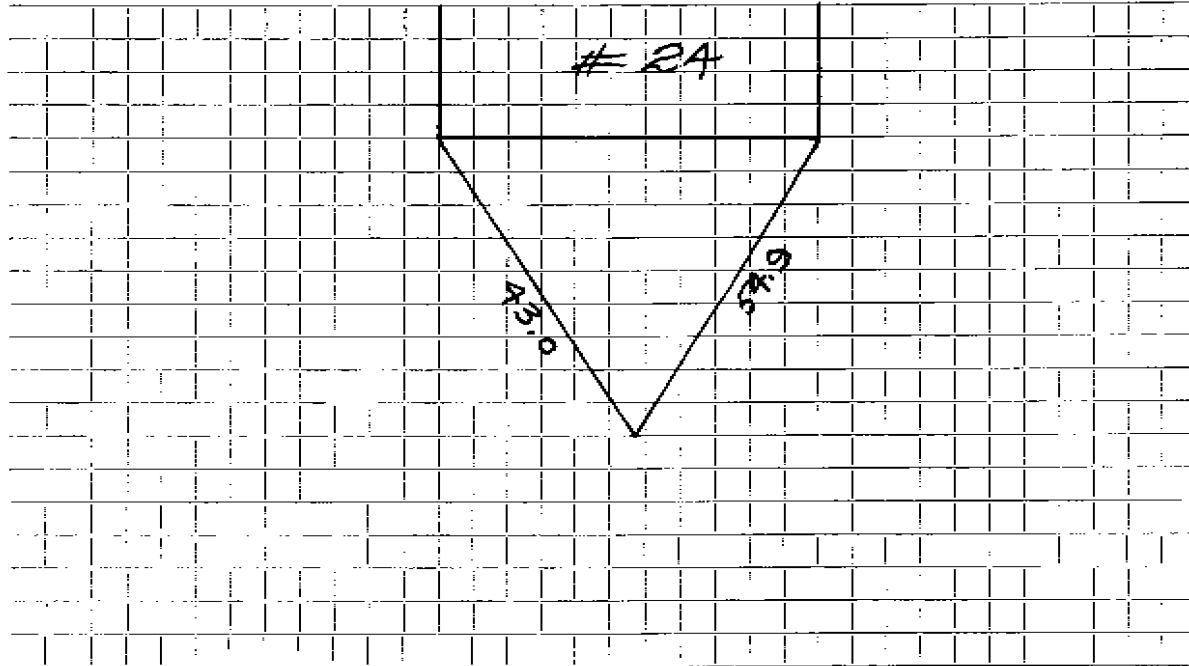

Connection made in ..... Street.      Work completed .....

Remarks: .....

.....

.....