
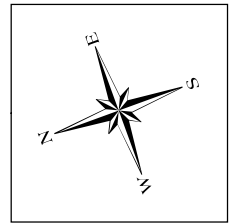


Water Service Tie Card
TOWN OF LEXINGTON
 MASSACHUSETTS

25 Hillcrest Road

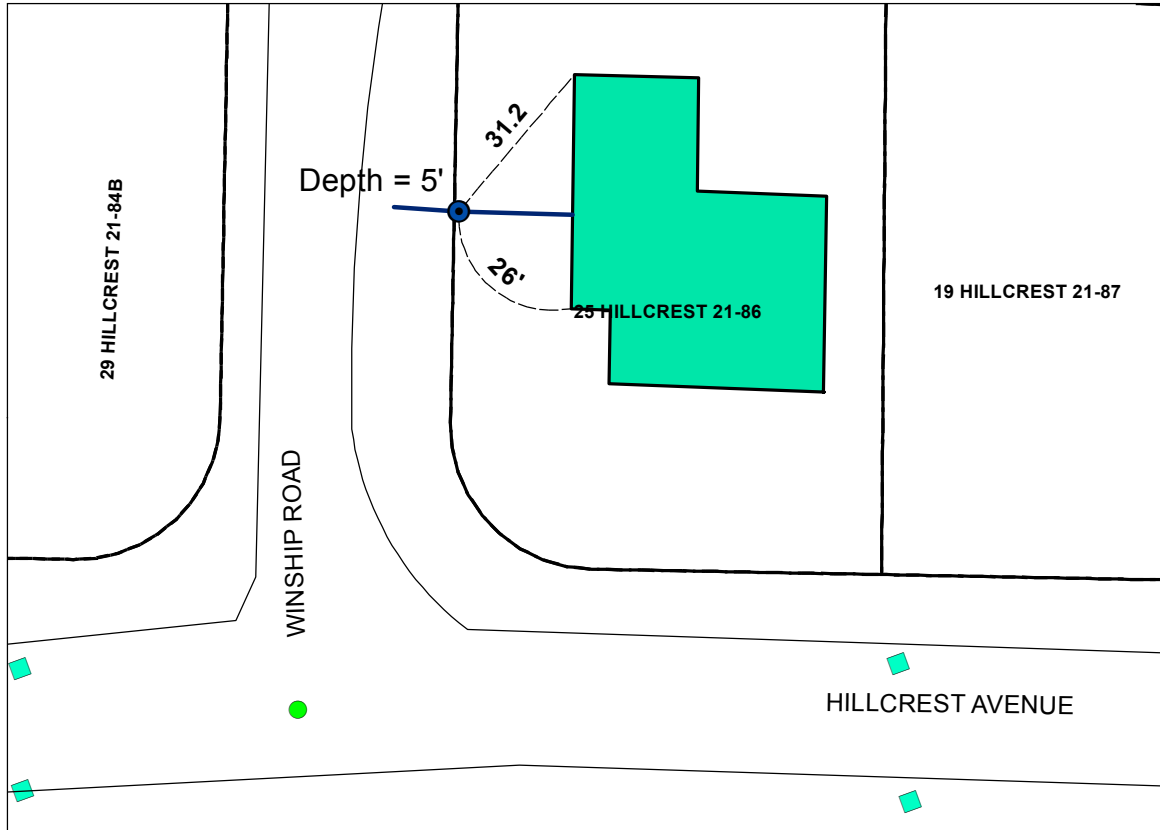

Legend

- Curb Stop
- Ties_Dimensions
- Water Service Line
- Property Line
- Edge of Pavement
- CATCH BASIN

Address	Map and Lot	Permit Number	Contractor Name	Inspector
25 Hillcrest Ave	21-86	5860	C&K Trucking	dpavlik msprague
Date	Material	Depth of Cover	Amount	
4/25/2014	1" Corp with saddle	5.0 ft	1	
	1" Copper type "k"	5.0 ft	11 ft	
	1" Curb Valve and Buffalo Box	5.0 ft	1	
	1" Copper type "k"	5.0 ft	20 ft	
Type of work completed				

New 1" water service to house from curb stop. New house on lot old house removed.