

Name Peter Nicoli

Service No. 3302

#6307

Address 29 Hillcrest

Lexington, Mass.

Location 29 Hillcrest Avenue

Kind of Pipe

Size

Size of Main

Repair - Renewal - New Service

Location

Date	Material	Amount	Total	Date	Amount
Jul. 16, '47	Labor	25 18	25 18	July 14, 47	50 00
	10% Overhead		2 32	Sept 25, 47	5 81
	39' - 3/4" Copper Tubing @ .27		10 53		42 13
	1 - 3/4" C x 3/4" E.W.T. S & W		3 15	Jul. 16, '47	6 68
	Trucking 1 hr. @ .75		75	17	31 74
			42 13	33' - 3/4" Copper Tubing @ .27	8 91
				1 - 3/4" C Corp-cock	3 00
				1 - 3/4" C x 3/4" C Curb-cock	3 68
				1 - Box & Rod	4 26
				1 - 3/4" C x 3/4" C Union (3 pts)	1 32
				1 - 3/4" Straight Tail Piece	30
				1 - 3/4" Offset Tail Piece	30
				Trucking 1 hr. @ .75	75
					59 94
	Labor				

Deposited
Refunded
Non-Charge

Hadley Press, Inc., Lexington

DATE _____

TOWN OF LEXINGTON - BOARD OF PUBLIC WORKS

WATER DIVISION

The undersigned applies for a supply of water at No. _____ St. and hereby agrees to comply with the rules and regulations as now, or at any future time, established by the Board of Selectmen.

Am't. of Estimate \$ _____


Owner _____

Am't. Paid \$ _____

Address _____

Builder _____

Sketch of Service Here

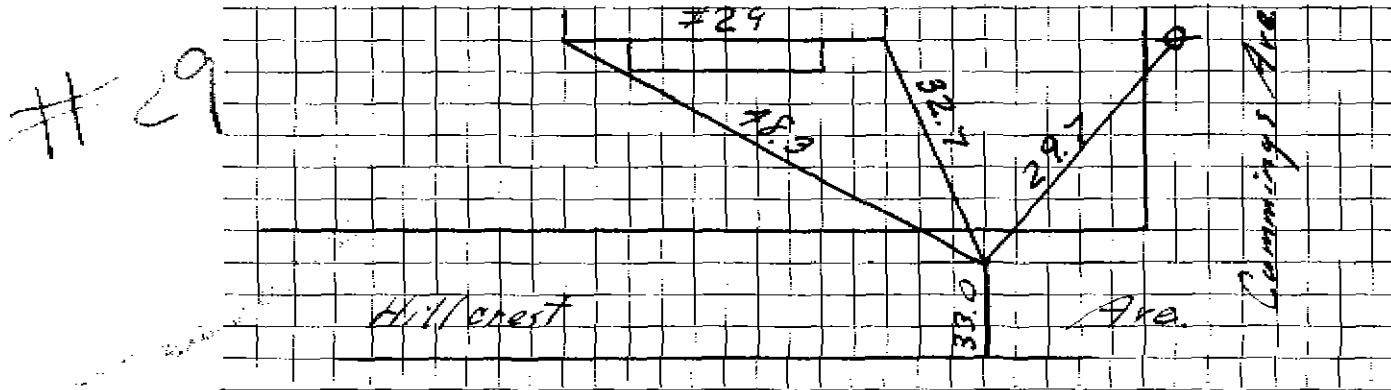

Connection made in _____ Street. Work completed _____ 19__

Remarks: