


DATE 11-12-97

TOWN OF LEXINGTON — BOARD OF PUBLIC WORKS
WATER DIVISION

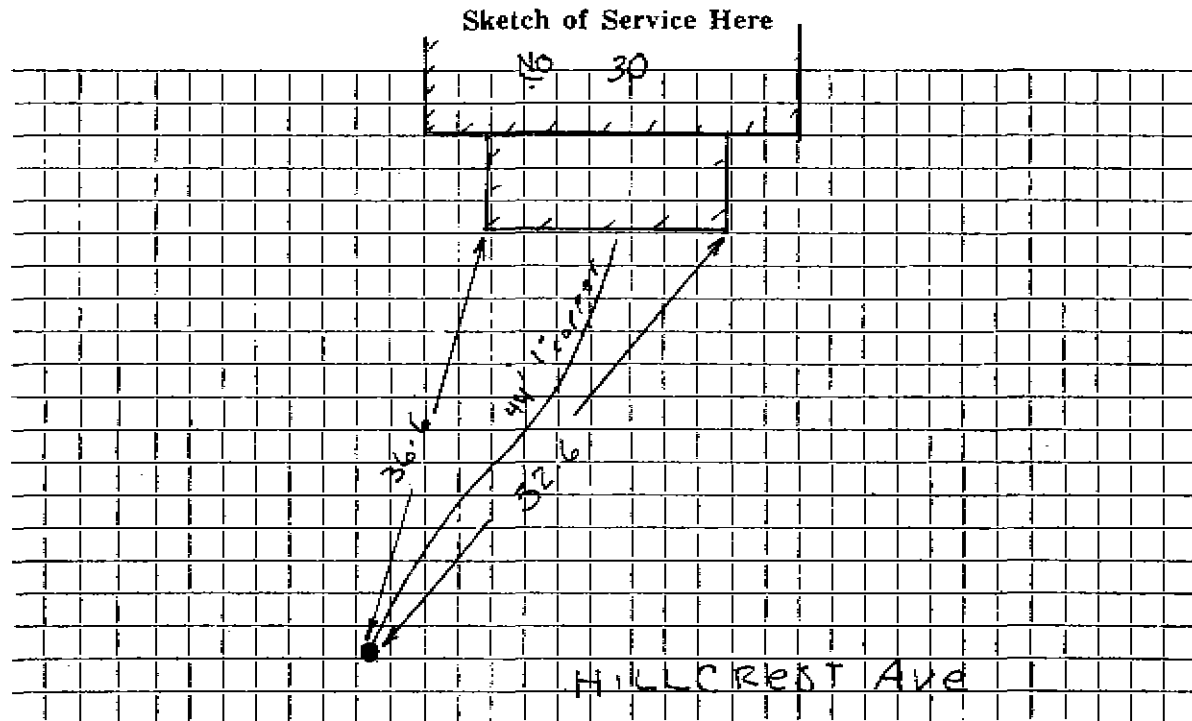

Connection made in HILLCREST AVE Street. Work completed

Remarks:

.....

.....