

WATER SERVICE RECORD

Name William E. Korman

Service No. 3

Address 32 Hillcrest Avenue

Location

~~Repair~~—Renewal—~~REG SERVICE~~ W.O. #4096

MAR 15 1976


Date	Material	Amount	Total	Date	Amount
2-25-76	Labor	88.74		2-25-76	300.00
	10% O.H.	8.87	97.61	3-15-76	130.72
	50' 3/4" Copper tubing @.67		33.50		149.28
	1 3/4" x 1/2" Bushing		1.56	4/1/76	
	1 3/4" x 1/2" Stop & Waste		15.43	15' 3/4 COPPER	
	1 3/4" 3 Part Union		4.69	3/4 CORP	
	1 Ground Clamp		.49	3/4 CURB	
	1 hr. Trucking		3.00	13 on + Rod	
	2 hrs. Town Shovel @6.50		13.00		
			169.28	Service moved Back 5'	
				8/23/68	1-3/4 CURB

DATE _____

TOWN OF LEXINGTON — BOARD OF PUBLIC WORKS

WATER DIVISION

Sketch of Service Here

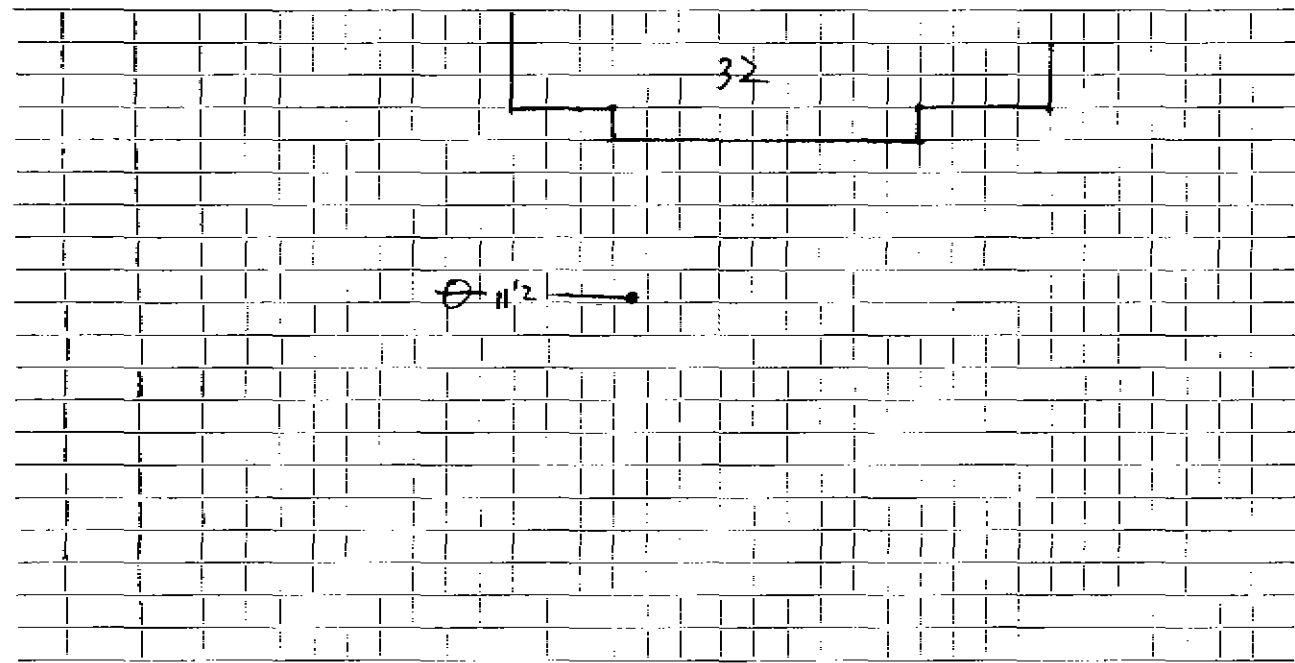

Connection made in Street. Work completed

Remarks:
.....
.....