

## WATER SERVICE RECORD

3722

Name Edward Tocio

Service No.

130

Address 33 Hillcrest Avenue

Location

~~Repair~~ ~~Renewal~~ - New Service W.O. #7614

Comm 12-10-62


Date	Material	Amount	Total	Date		Amount
10-1-62	Labor	20.66		9-19-62	Deposit	150.00
	10% O.H.	2.07	22.73	12-16-62	Refund	67.25
	55' 3/4" Copper tubing @42		23.10			82.75
	1 3/4" CX 1/2 I.W.H. Stop & Waste		6.17			
	1 1/2 Hrs. Town Shovel @6.50		9.75		NON CHARGE	
	1 Hr. Trucking @3.00		3.00	10-2-62	Labor	9.02
	18 X 3 Patch		18.00	24'	3/4" Copper tubing @42	10.08
			82.75	1	3/4" C Corp Cock	4.91
				1	3/4" C Curb Cock	6.28
				1	Box & Rod	4.90
				1	1/2 Straight Tailpiece	.50
				1	1/2 Offset Tailpiece	.50
				1	Hr. Trucking @3.00	3.00
				1/2	Hr. Town Shovel @6.50	3.25
						42.44
				8/24/68	Curb moved BACK 10'	
				1	3/4 Curb Cock	

DATE \_\_\_\_\_

**TOWN OF LEXINGTON — BOARD OF PUBLIC WORKS**

**WATER DIVISION**

Sketch of Service Here

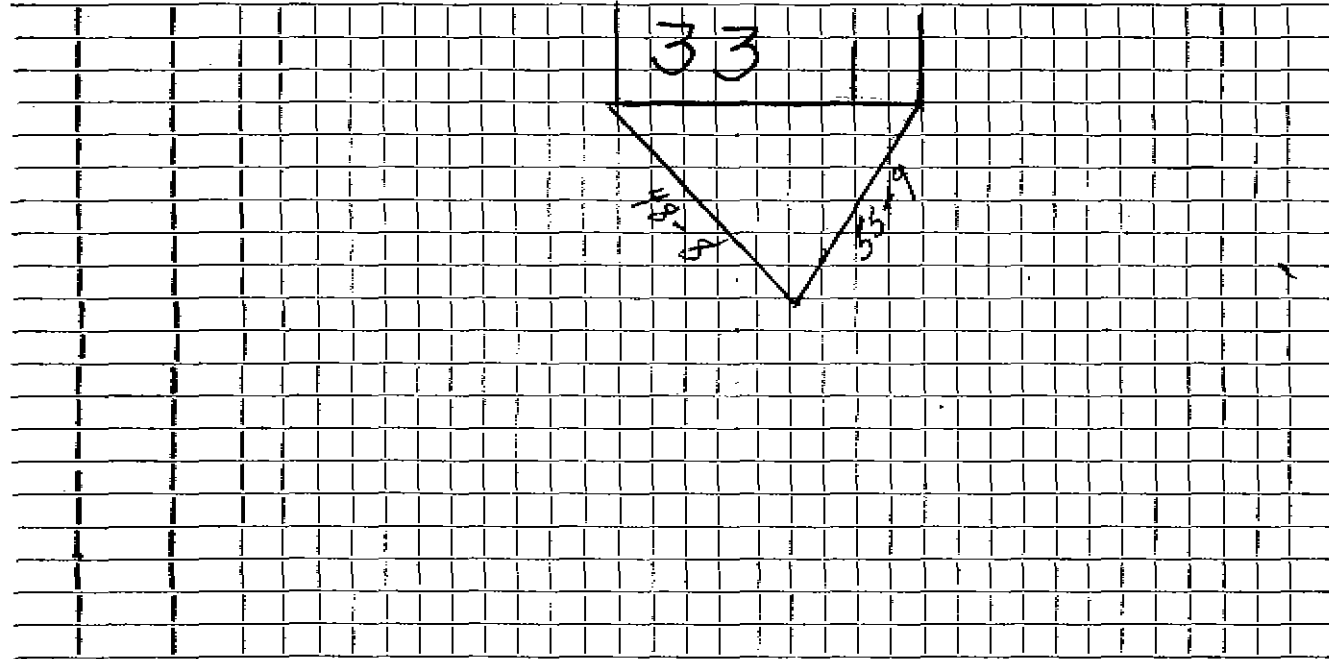

Connection made in \_\_\_\_\_ Street. Work completed \_\_\_\_\_

Remarks: \_\_\_\_\_  
\_\_\_\_\_  
\_\_\_\_\_