

WATER SERVICE RECORD

Name Pascuale Tozzo

Service No. 395

Address 25 Hillcrest Ave.

#7224

Location Lexington

Repair ~~REVIEWED~~ New Service

Came 12-4-53


Date	Material	Amount	Total	Date	Amount
11/30/53	Labor	1.35		12/1/53	No Deposit
	10% overhead	.43	1.78	12/9/53	Paid
	1'-3/4" Copper tubing @ .3629	15.92			NON CHARGE
	1-3/4" C x 1.I.W.2. stop & waste	4.00		12/1/53	Labor
	1/3 Hr. Littlefield shovel @ 7.50	22.50	10'-3/4" Copper tubing @ .3629		25.00
	1 Hr. Trucking	.75	1-3/4" C. Corp -cock		1.33
		4.80	1-3/4" C x 3/4" C. Curb -cock		1.67
			1-Box & Rod		3.90
			1-1/2 straight tail piece		.50
			1-1/2 offset tail piece		.50
			3 hr. Littlefield shovel @ 7.50		22.50
			1 Hr. Trucking		.75
					76.67
					3/25/68 4' 3/4 COPPER
					3/4 4' 100 ft
					10.00

DATE _____

#35

TOWN OF LEXINGTON — BOARD OF PUBLIC WORKS
WATER DIVISION

Sketch of Service Here

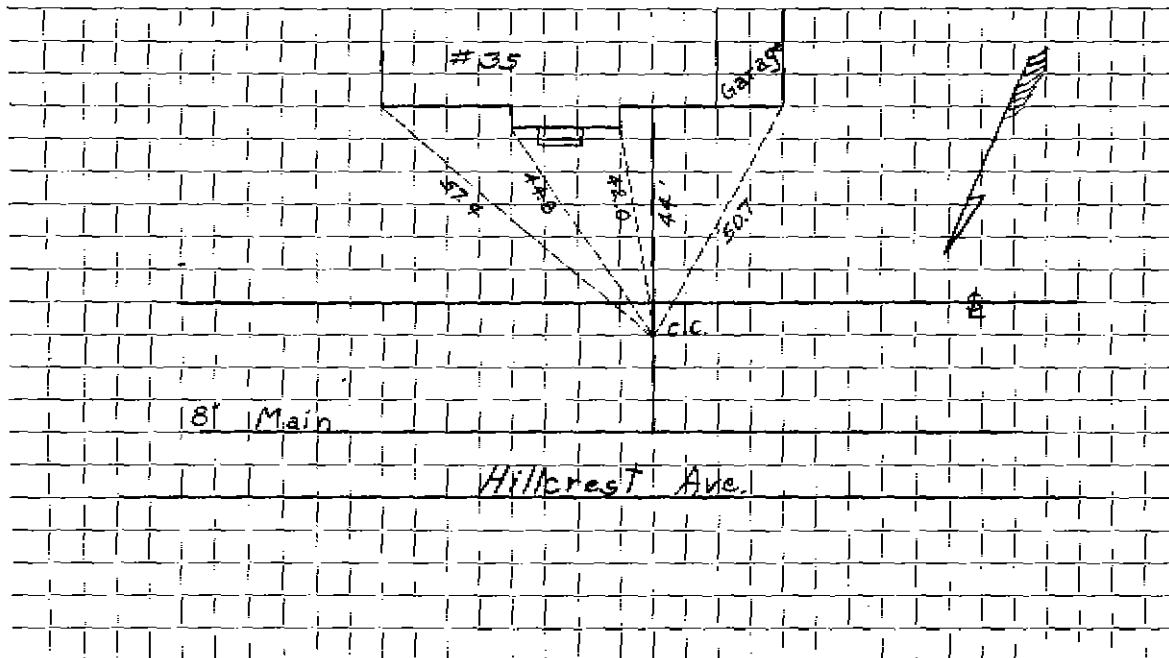

Connection made in Street: Work completed

Remarks:

.....