

## WATER SERVICE RECORD

Service No. 24

Name Edward Tocio

Address 37 Hillcrest Avenue

Location

~~Repair~~ New Service W.O. #7844

Comm 8-26-63

Date	Material	Amount	Total	Date	Amount	
4-23-63						
6-7-63	Labor	43.94		4-15-63	Deposit	100.00
	10% O.H.	4.39	48.33	9-26-63	Refund	2.14
58'	3/4" Copper tubing @.42		24.36			97.86
1	3/4" C x 1/2 I.W.H. Stop & Waste		6.17		NON CHARGE	
2	hrs. Town Shovel @6.50		13.00		Labor	28.04
2	hrs. Trucking @3.00		6.00	37'	3/4" Copper tubing @.42	15.54
			97.86	1	3/4" C Corp Cock	4.91
				1	3/4" C Curb Cock	6.26
				1	Box & Rod	4.90
				1	1/2 Straight tailpiece	.50
				1	1/2 Offset tailpiece	.50
						60.65


DATE \_\_\_\_\_

TOWN OF LEXINGTON — BOARD OF PUBLIC WORKS

WATER DIVISION

Sketch of Service Here

#37

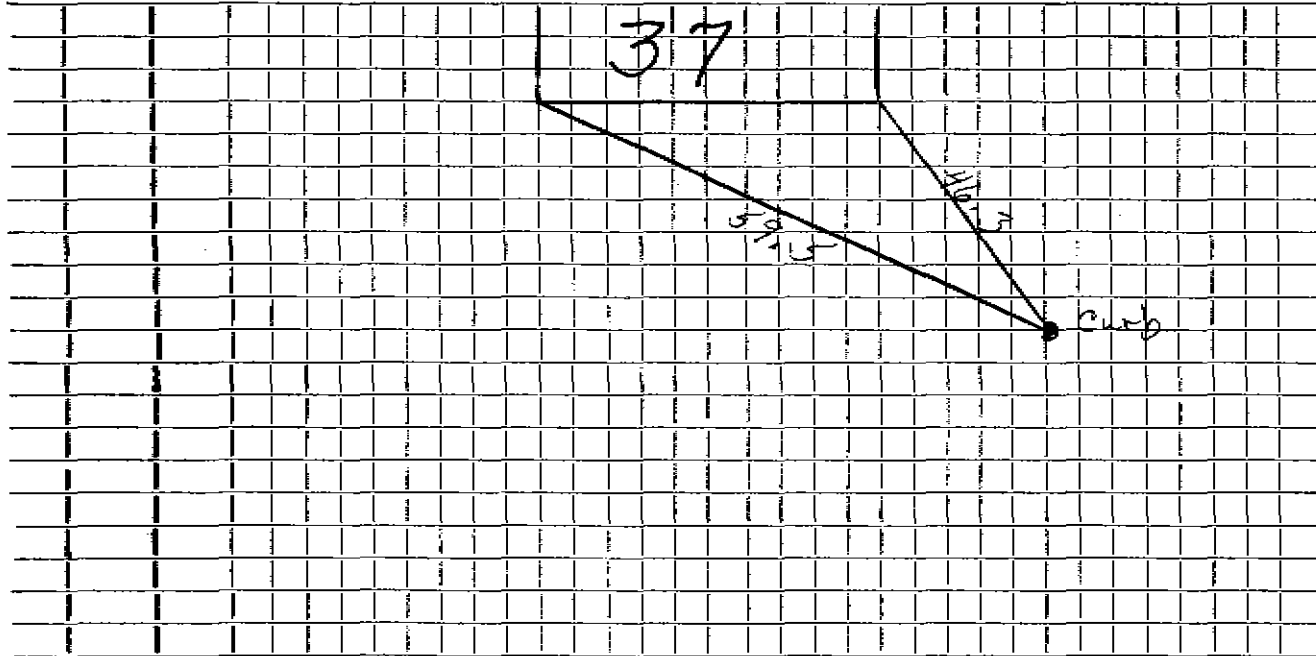

Connection made in . . . . . Street. Work completed . . . . .

Remarks: . . . . .  
. . . . .  
. . . . .