

## WATER SERVICE RECORD

Name

Service No.

Address

43 Hillcrest Avenue

Lots Pt. 267, 268 &amp; 269

Location

curb to main

~~Repair or Renewal~~ New Service

W.O. # 6106

Date	Material	Amount	Total	Date	Amount
6/11/69	Labor	98.68			
	10% O.H.	9.87			
		108.55	108.55		
	33' 3/4" copper @ .79		26.07		
	1 3/4" curb cock		11.32		
	1 3/4" corporatim		9.57		
	Box and rod		5.10		
			\$ 160.61		


DATE \_\_\_\_\_

TOWN OF LEXINGTON — BOARD OF PUBLIC WORKS

WATER DIVISION

Sketch of Service Here

#41

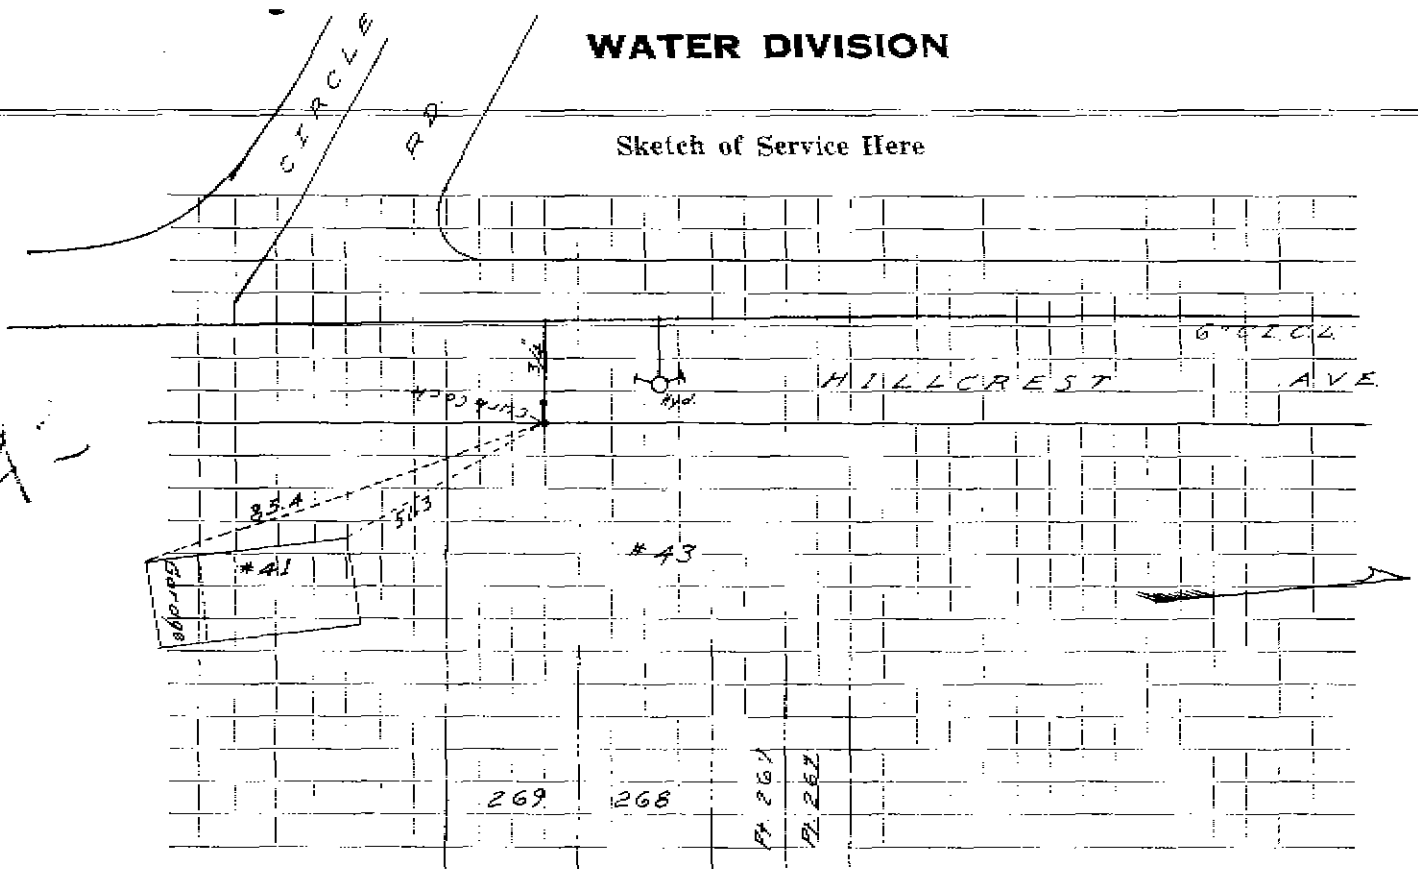

Connection made in ..... Street. Work completed .....

Remarks: .....  
.....  
.....