

Name Casimiro Bertini

Service No.

1274

Address Hillcrest Ave.

Location

Kind of Pipe

Size

Size of Main

~~xRepair~~~~xRenew~~—New Service

Location

Date	Material	Amount	Total	Date	Amount
7/20/34	30 3/4" C. Tubing @ .18	\$5 40		July 4 1934 - Deposited	13 50
1	S & W	2 75			
	Trucking	75	\$8 90		
4	Hrs. Labor @ .55	2 20			
2	" " @ .60	1 20	3 40		
	10% overhead		34		
			12 64		
	<u>COST</u>				
	<u>CHARGE</u> 30 ft. @ .45	\$13 50	\$13 50		
	Labor				

Madley Press, Inc., Lexington

45

DATE _____

TOWN OF LEXINGTON—BOARD OF PUBLIC WORKS WATER DIVISION

The undersigned applies for a supply of water at No. _____ St. and hereby agrees to comply with the rules and regulations as now, or at any future time, established by the Board of Selectmen.

Am't. of Estimate \$ 13⁰⁰

Owner Casimiro R. R. R.


Am't. Paid \$ 13⁰⁰

Address Hillcrest Avenue

Builder _____

Lexington, Mass.

Sketch of Service Here

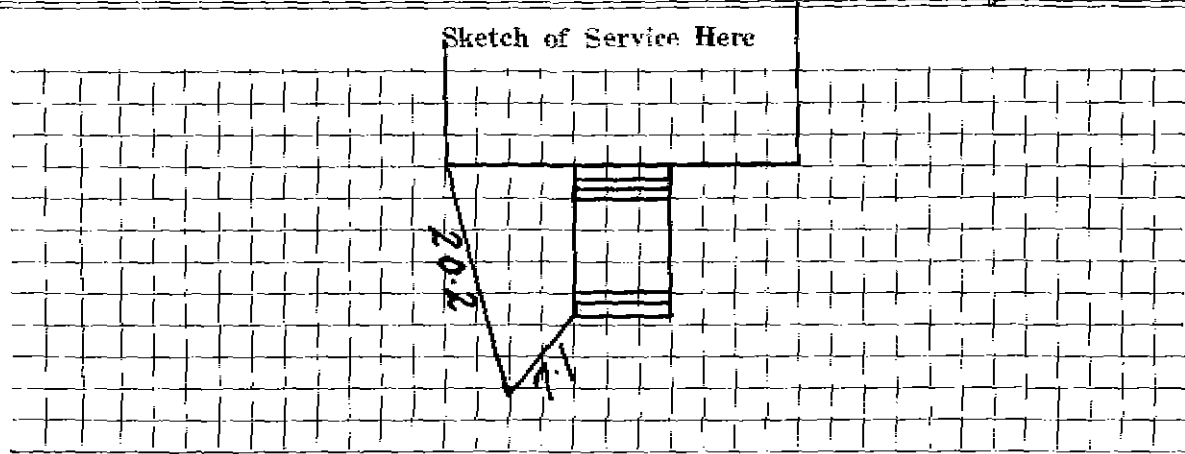

Connection made in _____ Street.

Work completed _____ 19

Remarks: