


DATE _____

TOWN OF LEXINGTON — BOARD OF PUBLIC WORKS

WATER DIVISION

Sketch of Service Here #7

LOT #19

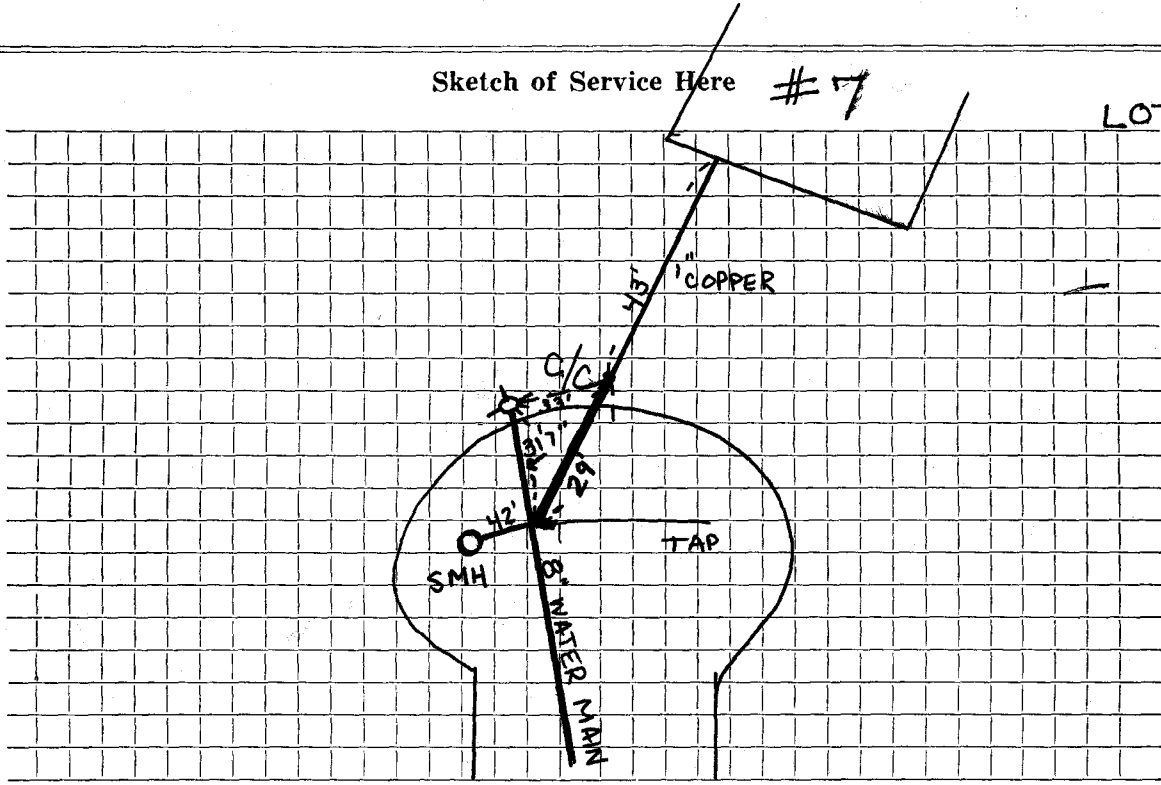

Connection made in ... MEAD CIRCLE Street. Work completed

Remarks:
.....
.....