

# Water Service Record

Name

Service No.

Address

5 Meadowbrook Ave


Location

Repair Renewal - New Service

Date	Material	Amount	Total	Date		Amount
6/2/2021	1" type K copper	60'				
	1" curb stop					
	open right					
	comb. brass					
	Buffalo Box					
	3/4" x 1" union					

TOWN OF LEXINGTON - BOARD OF PUBLIC WORKS  
WATER DIVISION

SKETCH OF SERVICE HERE

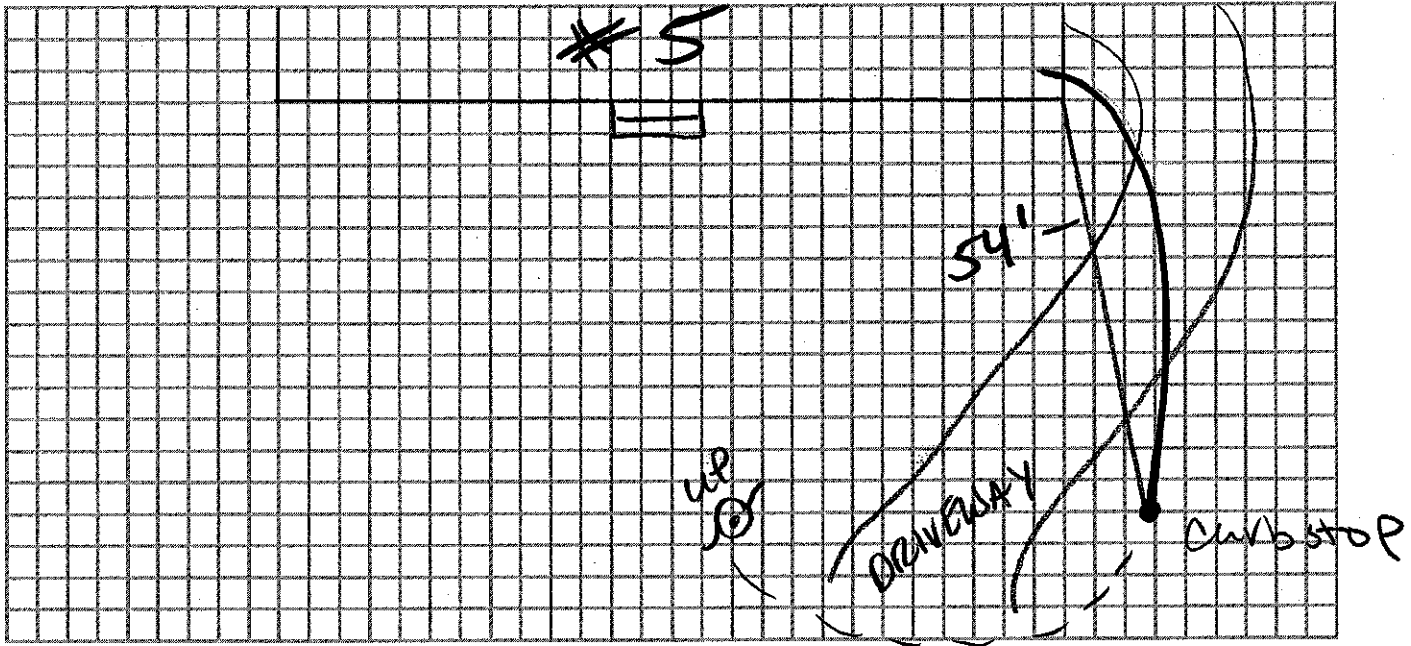

Connection made in: Meadowbrook Ave Street.

Work completed: 19'

Remarks: