

WATER SERVICE RECORD

Name Eugene Bewig

Service No.

55

Address 6 Melrose Avenue

Location Lexington

~~REPAIR WORK~~ - New Service COM...4-6-53


Date	Material	Amount	Total	Date	Amount
3/25/53	Labor	5 03		3-18-53 Deposited	100 00
	10% overhead	50	5 53	4-6-53 Refunded	77
	30' - 1" copper tubing@ .3997		11 99		<u>NON CHARGE</u>
	140' - 1" copper tubing@ .3997		55 96	3/24/53 Labor	23 20
	1 - 1" C x 3/4" I.W.H.stop & waste	4 00		1 - 1" c. corp-cock	5 61
	3 hrs.Littlefield shovel @7.	21 00		1 - 1" C x 1" C. curb-cock	6 80
	1 hr. trucking		75	1 box and rod	3 90
			99 23	1 - 1/2 straight tail piece	50
				1 - 1/2 offset tail piece	50
				1 hr. Littlefield shovel	7 00
				1 hr. trucking	75
					<u>48 26</u>

DATE \_\_\_\_\_

TOWN OF LEXINGTON — BOARD OF PUBLIC WORKS

WATER DIVISION

Sketch of Service Here

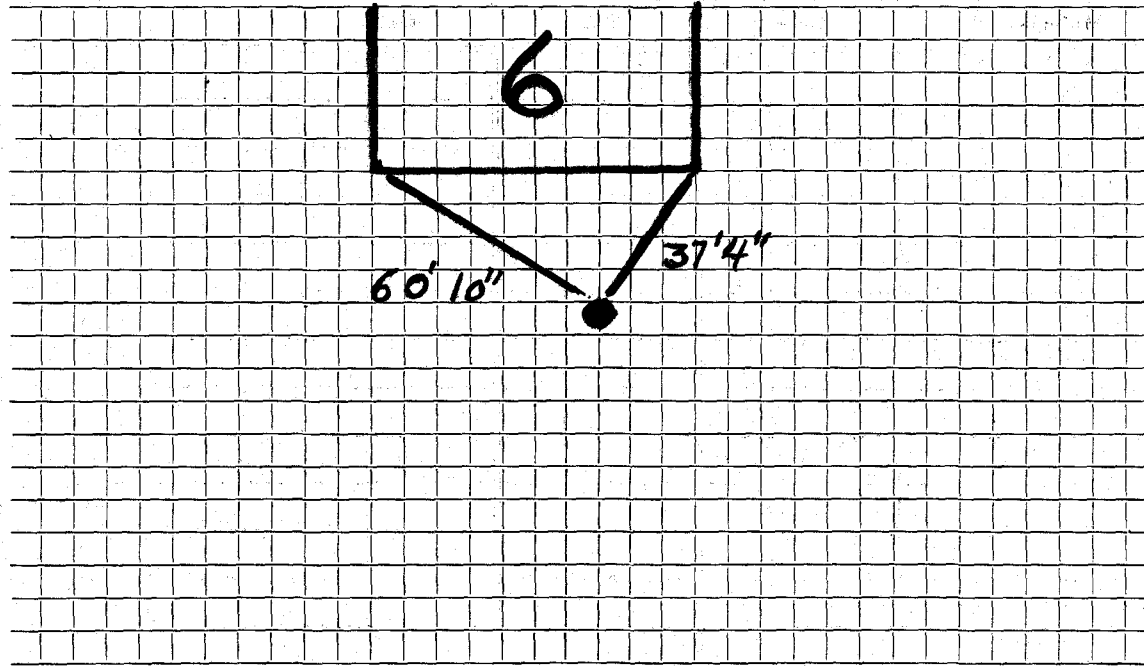

Connection made in ..... Street. Work completed .....

Remarks: .....

.....

.....