

Name Robert Merriam

Service No. ~~5#~~ 1945

Address 4 Oakmount Circle
10 Merriam St.

6704

Location 10 Merriam St., (1st on left)

Kind of Pipe

Size

Size of Main

~~Repair - Renewal~~ - New Service

Location

Date	Material	Amount	Total	Date	Amount
1936					
Dec. 11	3 hrs. @ 60¢	1 80		Feb. 5, 1937	23 00
<i>Com 12-22-36</i>	6 " @ 55¢	3 30	5 10	<i>Cash</i>	
	10% Overhead		51		
			5 61		
	46' Cop. Tub. @ 21¢	9 66			
	1 S. and W.	1 75	11 41		
			17 02		
	Say:				
	46' at 50¢		\$ 23 00	<i>Bill sent 12-24-36</i>	
	Labor				

Hadley Press, Inc., Lexington

DATE Dec 3, 1936

TOWN OF LEXINGTON—BOARD OF PUBLIC WORKS

WATER DIVISION

The undersigned applies for a supply of water at No. 10 Merriam St. and hereby agrees to comply with the rules and regulations as now, or at any future time, established by the Board of Selectmen.

Am't. of Estimate \$ _____


Owner Robert Merriam.

Am't. Paid \$ _____

Address 4. Clammount Circle
Lexington

Builder J. G. Black

Sketch of Service Here

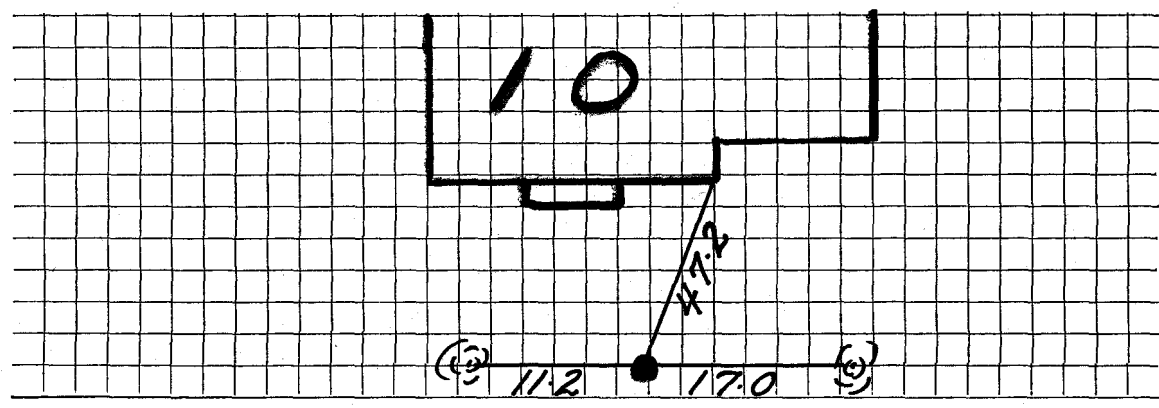

Connection made in _____ Street. Work completed _____ 19

Remarks: