

WATER SERVICE RECORD

Name

Service No.

Address 100 HERIAM ST.

Location

Repair—Renewal—New Service


Date	Outside	Material	Amount	Total	Date		Amount
8/17/92		15 LF 1" COPPER					
		1" CORP					
		1" CURB W/BOX					
		.6" TAILPIECE			6-18-'63	<u>Inside</u>	
		3/4" X 1" RED.				37' 3/4" Copper	
						1 3/4" C. X 1/2" I.W. H. Stop + Waste	
						1 1" C. X 3/4" C. - 2 Part Union	

DATE \_\_\_\_\_

# TOWN OF LEXINGTON — BOARD OF PUBLIC WORKS

## WATER DIVISION

Sketch of Service Here

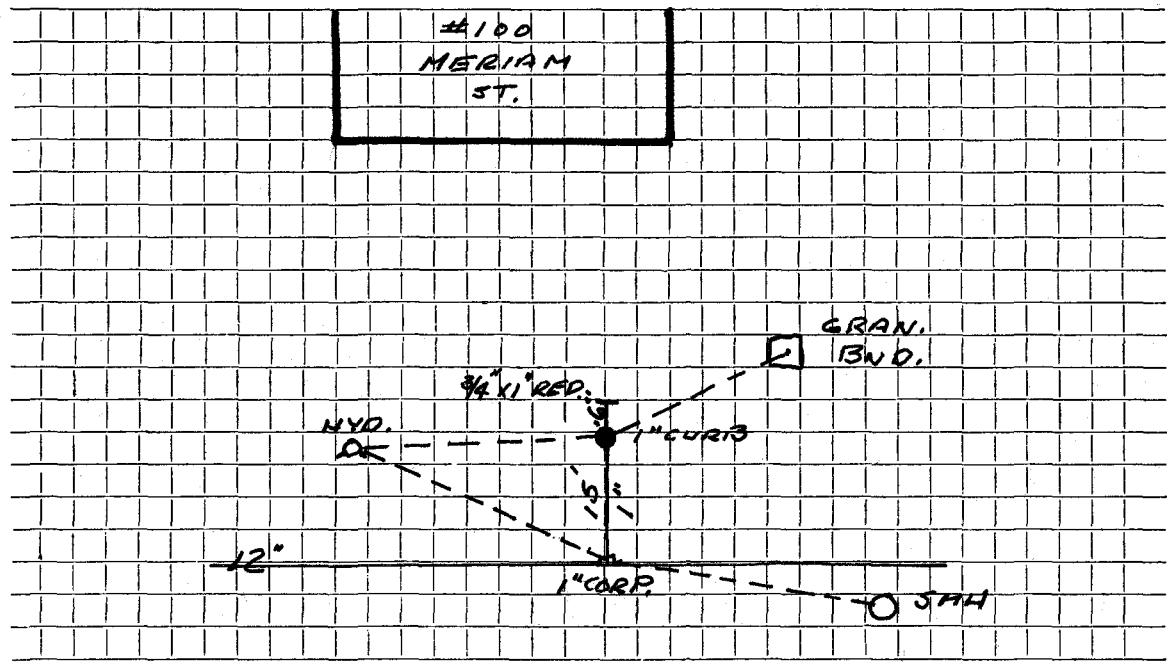

Connection made in MERIAM Street. Work completed .....

Remarks: BISZKO - O.S. CONTR. Original Service 6-7-'35'